

Registration Statement

OF CLAIMANT OF RIGHT TO APPROPRIATE GROUND WATER

TO THE STATE ENGINEER OF OREGON:

I, Eugene D MacCarthy
of RT3 Box 833 Salem County of Marietta
(Mailing address)

State of Oregon, do hereby make application for a certificate of registration as evidence of a right to appropriate ground water.

- 1. Source from which water is withdrawn is Pump Well #4
(Flowing well, pump well, infiltration trench, or tunnel)
- 2. Location is: 2 Miles East of Independence
(Approximate distance and direction from nearest city or town)

and is more particularly described as follows:

(a) 505 Ft S & 295 Ft W From East 1/4 Corner of Sec 27
(Give distance and bearing to corner of section or other legal subdivision)
being within NE 1/4 SE 1/4 of Sec. 27, Twp. 8 S, Rge. 4 W
(Smallest legal subdivision) (N. or S.) (E. or W.)

or (b) within limits of recorded platted property, town or city:

in Lot _____, Block _____ of _____
(Name of plat or addition)
County of Marietta
(If within city or town, give name)

3. Construction Work was begun on June 1950; was completed on June 1950
(Date) (Date)
and the ground water claimed was first used for the purposes set out below on June 1950
(Date)

since which time the water has been used Farm Irrigation - Intermittently
(Continuously or Intermittently)
from June 1950 to Still in Use
(Date) (Date)

4. Quantity of water claimed and used is 1000 gallons per minute; _____ acre feet per year.

5. Purpose or Purposes for which water is used Farm Irrigation

6. Description of Well: Depth 30 feet. Type drilled
(Domestic, irrigation, municipal, manufacturing, industrial, etc.) (Dug or drilled)
diameter 10 inches. Elevation of ground at well site _____ feet, mean sea level.
(As near as known)
Depth to water table 8 feet. Ave. eye

7. Capacity of Well: 1000 g.p.m. with 4 feet drawdown.
_____ g.p.m. with _____ feet drawdown.

Date of test No Test

If Flowing Well: Measured discharge _____ g.p.m. on _____
(Date)

Shut-in pressure at ground surface _____ lbs. per sq. in. on _____
(Date)

Water is controlled by _____
(Cap, valve, etc.)

8. Casing: (Give diameter, commercial specifications and depth below ground surface of each casing size.)

10 inch diameter from .0 to 30 feet
 inch diameter from to feet
 inch diameter from to feet
 inch diameter from to feet

Describe and show depth of shoe, plug, adapter, liner or other details:

9. Perforated Casings or Screens:

1000 Perforated from 18' to 30'
(Number per foot and size of perforations, or describe screen)
 from to
 from to
 from to

10. Log of Well: (Describe each stratum or formation clearly, indicate if water bearing, and give thickness and depth as indicated.)

MATERIAL	Thickness (Feet)	Depth to Bottom (Feet)
Soil	Top 8'	
River gravel & Sand	Balance of depth	22'

If log of well is not available, give name and address of driller. A. Clinton

Independence, Ore

11. Infiltration Trench: Covered or open _____
 Dimensions: Length _____ ft. Minimum depth _____ ft. Maximum depth _____ ft.
 Bottom width _____ ft. Discharge _____ g.p.m. Date of test _____

12. Tunnel: Type of lining _____
 Dimensions: _____
 (Length, course, and cross sectional size)
 Position of water bearing stratum with reference to portal of tunnel _____

Log of tunnel: (Preceding table for log of well may be used, if desired. Give footage from portal and character of materials, as pertinent.)


13. Pumping Equipment:
 (a) Pump Fairbanks Split Case 5" Capacity 1500 g.p.m.
(Make, type, and size)
 (b) Motor Electric 75HP or Diesel 100HP
(Type and horsepower)

14. Location of area irrigated or to be irrigated, or place of use if for purposes other than irrigation.

Township North or South	Range E. or W. of Willamette Meridian	Section	Forty-acre Tract	Number Acres To Be Irrigated	Date of Reclamation
8S	4W	27	NE 1/4 SE 1/4	37.5	1950
8S	4W	27	NW 1/4 SE 1/4	6.0	"
				<u>43.5</u>	
<p><i>This farm owns and operates several pumps of various capacities depending on water needs in various fields or crops any one of 6 different pumps listed below may be in this well</i></p>					
1-	100 HP	Fairbanks	diesel powered	5" pump	
2-	75 "	"	Electric	"	"
3-	40 "	"	"	"	"
4-	15 "	"	"	"	3" "
5-	15 "	Pacific	"	"	3" "
6-	30 "	Fairbanks	diesel	"	5" "

15. If the ground water supply is supplemental to an existing water supply, identification of any application for a permit, permit, certificate or adjudicated right to appropriate water made or held by the registrant.
part of area listed above is also irrigated from a lake under App. 14405 Permit 14973 - Water Right Certificate 15743

Township 85 Range 4W, W.M.
North

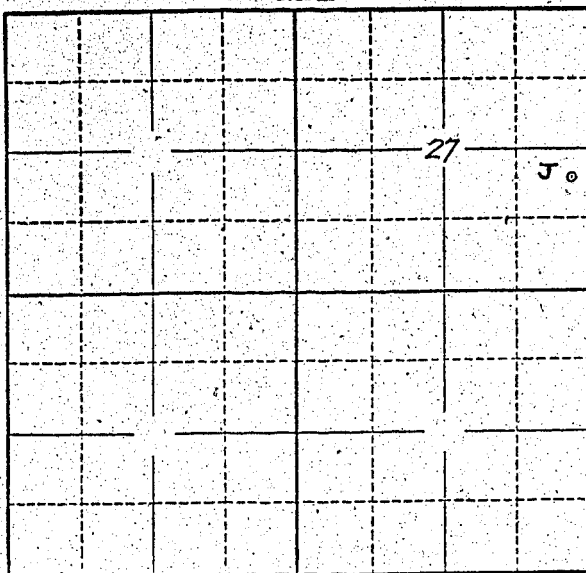

Locate well and acreage of irrigated land on plat.
Scale: 2" = 1 Mile

STATE OF OREGON

County of Marion } ss.

I, Eugene D. MacCarty, being first duly sworn, do hereby certify that I have read the foregoing Registration Statement and that all of the items therein contained are true to the best of my knowledge and belief.

Eugene D. MacCarty
(Signature of Registrant)

Subscribed and sworn to before me this 22 day of July, 1958.

My commission expires 9/27/58 Jeanie Baxter
(Notary Public)

(SEAL)

CERTIFICATE OF REGISTRATION

STATE OF OREGON }
County of Marion } ss.

This is to certify that the foregoing Registration Statement was received in the office of the State Engineer on the 22nd day of July, 1958, at 9:00 o'clock A. M. and has been duly recorded in said office in Book No. 10 of Registration Statements on page GR-2353.

Witness my hand this 10th day of March, 1959
Leura A. Stanley
(State Engineer)

17.10

By _____ (Deputy)

GR - 2353