

Registration Statement

OF CLAIMANT OF RIGHT TO APPROPRIATE GROUND WATER

(Under Chapter 708, Oregon Laws 1955.)

TO THE STATE ENGINEER OF OREGON:

I, Dorsey B. Gray
of Rt. 1 Box 87 Humsville County of Marion

State of Oregon, do hereby make application for a certificate of registration as evidence of a right to appropriate ground water.

- 1. Source from which water is withdrawn is Pump well #1
(Flowing well, pump well, infiltration trench, or tunnel)
- 2. Location is: 3 Mi. S.W. of Stayton
(Approximate distance and direction from nearest city or town)

and is more particularly described as follows:

(a) West 2611.7' South 2389.7' NE Cor. Sec 20
(Give distance and bearing to corner of section or other legal subdivision)

being within SW 1/4 NE 1/4 of Sec. 20, Twp. 9S, Rge. 1W.W.M
(Smallest legal subdivision) (N. or S.) (E. or W.)

or (b) within limits of recorded platted property, town or city:

in Lot _____, Block _____ of _____
(Name of plat or addition)

County of _____
(If within city or town, give name)

3. Construction Work was begun on April 1947; was completed on May 8, 1947
(Date) (Date)

and the ground water claimed was first used for the purposes set out below on May 1947
(Date)

since which time the water has been used Continuously
(Continuously or Intermittently)

from May 1947 to Date of this filing
(Date) (Date)

4. Quantity of water claimed and used is 320 gallons per minute; _____ acre feet per year.

5. Purpose or Purposes for which water is used Specialty crop and pasture irrigation

(Domestic, irrigation, municipal, manufacturing, industrial, etc.)

6. Description of Well: Depth 31 1/2 feet. Type Drilled
(Dug or drilled)

diameter 10 inches. Elevation of ground at well site 375' feet, mean sea level.
(As near as known)

Depth to water table 8 feet.

7. Capacity of Well: Unknown g.p.m. with _____ feet drawdown.

_____ g.p.m. with _____ feet drawdown.

Date of test _____

If Flowing Well: Measured discharge _____ g.p.m. on _____
(Date)

Shut-in pressure at ground surface _____ lbs. per sq. in. on _____
(Date)

Water is controlled by _____
(Cap, valve, etc.)

Well #1

8. Casing: (Give diameter, commercial specifications and depth below ground surface of each casing size.)

10" inch diameter from to feet
 inch diameter from to feet
 inch diameter from to feet
 inch diameter from to feet

Describe and show depth of shoe, plug, adapter, liner or other details:

.....

9. Perforated Casings or Screens:

Unknown from to
 (Number per foot and size of perforations, or describe screen)
 from to
 from to
 from to

10. Log of Well: (Describe each stratum or formation clearly, indicate if water bearing, and give thickness and depth as indicated.)

MATERIAL	Thickness (Feet)	Depth to Bottom (Feet)
<i>No log</i>		

If log of well is not available, give name and address of driller. Wymore, Address Unknown

11. Infiltration Trench: Covered or open

Dimensions: Length ft. Minimum depth ft. Maximum depth ft.
Bottom width ft. Discharge g.p.m. Date of test

12. Tunnel: Type of lining

Dimensions:
(Length, course, and cross sectional size)

Position of water bearing stratum with reference to portal of tunnel

Log of tunnel: (Preceding table for log of well may be used, if desired. Give footage from portal and character of materials, as pertinent.)

13. Pumping Equipment:

(a) Pump Jacuzzi 5x4 Capacity 400 g.p.m.
(Make, type and size)

(b) Motor 1.5 HP Electric
(Type and horsepower)

14. Location of area irrigated or to be irrigated, or place of use if for purposes other than irrigation.

Township North or South	Range E. or W. of Willamette Meridian	Section	Forty-acre Tract	Number Acres To Be Irrigated	Date of Reclamation
9S	1W	20	NW 1/4 S.E 1/4	13 5	1947
9S	1W	20	SW 1/4 NE 1/4	13 11	1947
			14.1 36 acres		
9S	1W	20	SE 1/4 NW 1/4	12	1947
9S	1W	20	NE 1/4 SW 1/4	8	1947
				Total 36	

15. If the ground water supply is supplemental to an existing water supply, identification of any application for a permit, permit, certificate or adjudicated right to appropriate water made or held by the registrant.


None

Township 9.5 Range 1 W W M, W.M.

See map attached

North

17 16
20 21

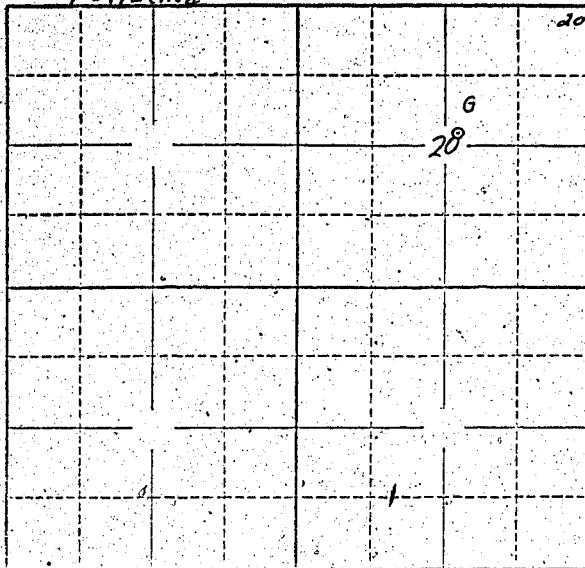

Locate well and acreage of irrigated land on plat.

Scale: 2" = 1 Mile

STATE OF OREGON

County of Marion } ss.

I, Dorsey B. Gray, being first duly sworn, do hereby certify that I have read the foregoing Registration Statement and that all of the items therein contained are true to the best of my knowledge and belief.

Dorsey B. Gray
(Signature of Registrant)

Subscribed and sworn to before me this 22nd day of July, 1958.

My commission expires Sept. 8, 1960

Chas. T. [Signature]
(Notary Public)

(SEAL)

CERTIFICATE OF REGISTRATION

STATE OF OREGON } ss.
County of Marion

This is to certify that the foregoing Registration Statement was received in the office of the State Engineer on the 22nd day of July, 1958, at 9³⁰ o'clock A.M. and has been duly recorded in said office in Book No. 10 of Registration Statements on page GR-2354

~~Construction shall be completed by the _____ day of _____, 19____, and the water conserved applied to _____~~

Witness my hand this 10th day of March, 1959

Lewis A. Stanley
(State Engineer)

\$15.00

By _____ (Deputy)

GR-2354