

OF CLAIMANT OF RIGHT TO APPROPRIATE GROUND WATER

(Under Chapter 708, Oregon Laws 1955.)

TO THE STATE ENGINEER OF OREGON:

I, Dorsey B. Gray  
of Rt. 1 Box 87 Humsville County of Marion

State of Oregon, do hereby make application for a certificate of registration as evidence of a right to appropriate ground water.

1. Source from which water is withdrawn is Pump well #3  
(Flowing well, pump well, infiltration trench, or tunnel)
2. Location is: 3 Mi. SW Stayton  
(Approximate distance and direction from nearest city or town)

and is more particularly described as follows:

(a) 1259.8' West 2103.9' South NE Corner Sec 20  
(Give distance and bearing to corner of section or other legal subdivision)  
being within \_\_\_\_\_ of Sec. 20, Twp. NW 33, Rge. 1 W W M.  
(Smallest legal subdivision) (N. or S.) (E. or W.)

or (b) within limits of recorded platted property, town or city:

in Lot \_\_\_\_\_, Block \_\_\_\_\_ of \_\_\_\_\_  
(Name of plat or addition)  
County of \_\_\_\_\_  
(If within city or town, give name)

3. Construction Work was begun on June 1948, was completed on June 1948  
(Date) (Date)

and the ground water claimed was first used for the purposes set out below on June 1948  
(Date)

since which time the water has been used Continuously  
(Continuously or intermittently)  
from June 1948 to Date this filing  
(Date) (Date)

4. Quantity of water claimed and used is 260 gallons per minute; \_\_\_\_\_ acre feet per year.

5. Purpose or Purposes for which water is used Specialty Crop + pasture irrigation  
(Domestic, irrigation, municipal, manufacturing, industrial, etc.)

6. Description of Well: Depth 30 feet. Type Drilled  
(Dug or drilled)  
diameter 8" inches. Elevation of ground at well site \_\_\_\_\_ feet, mean sea level.  
(As near as known)  
Depth to water table 9' feet.

7. Capacity of Well: Unknown g.p.m. with \_\_\_\_\_ feet drawdown.  
\_\_\_\_\_ g.p.m. with \_\_\_\_\_ feet drawdown.

Date of test \_\_\_\_\_

If Flowing Well: Measured discharge \_\_\_\_\_ g.p.m. on \_\_\_\_\_  
(Date)


Shut-in pressure at ground surface \_\_\_\_\_ lbs. per sq. in. on \_\_\_\_\_  
(Date)

Water is controlled by \_\_\_\_\_  
(Cap, valve, etc.)





Township 95 Range 1W, W.M.

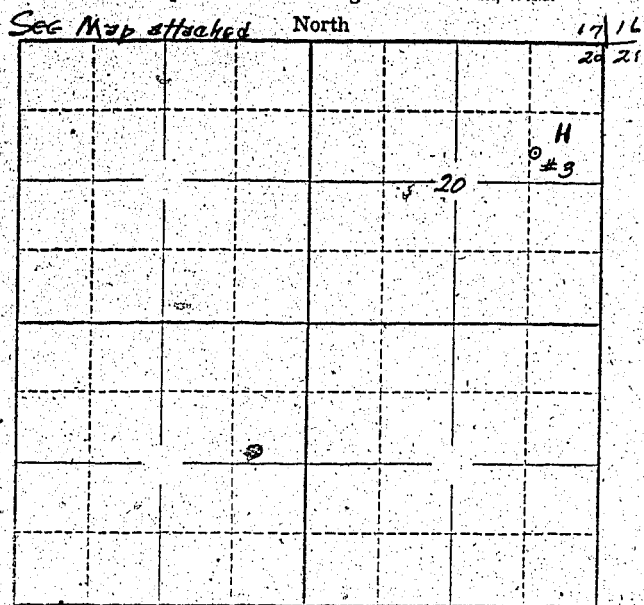

Locate well and acreage of irrigated land on plat.  
Scale: 2" = 1 Mile

STATE OF OREGON }  
County of Marion } ss.

I, Dorsey B. Gray, being first duly sworn, do hereby certify that I have read the foregoing Registration Statement and that all of the items therein contained are true to the best of my knowledge and belief.

Dorsey B. Gray  
(Signature of Registrant)

Subscribed and sworn to before me this 22<sup>nd</sup> day of July, 1958.

My commission expires Sept. 8, 1960 Chas. T. [unclear]  
(Notary Public)

(SEAL)

**CERTIFICATE OF REGISTRATION**

STATE OF OREGON }  
County of Marion } ss.

This is to certify that the foregoing Registration Statement was received in the office of the State Engineer on the 22nd day of July, 1958, at 9:30 o'clock A.M. and has been duly recorded in said office in Book No. 10 of Registration Statements on page GR-2356

~~Registration Statement was received in the office of the State Engineer on the [unclear] day of [unclear], 19[unclear], at [unclear] o'clock [unclear].M. and has been duly recorded in said office in Book No. [unclear] of Registration Statements on page [unclear]~~

Witness my hand this 10<sup>th</sup> day of March, 1959

Lewis A. Stanley  
(State Engineer)

\$15.00

By \_\_\_\_\_ (Deputy)

GR-2356