

Well #2
\$1530

Registration No. GR - 2495
Certificate No. GR - 2362

Registration Statement

OF CLAIMANT OF RIGHT TO APPROPRIATE GROUND WATER

TO THE STATE ENGINEER OF OREGON:

I, Ruby Alexander Trustee
of 4535 Dallas Road Salem County of Polk
(Mailing address)

State of Oregon, do hereby make application for a certificate of registration as evidence of a right to appropriate ground water.

1. Source from which water is withdrawn is pump well
(Flowing well, pump well, infiltration trench, or tunnel)
2. Location is: 9 miles east of Jefferson, Oregon
(Approximate distance and direction from nearest city or town)

and is more particularly described as follows:

(a) 17 Ch. NE 8 Ch W from the SE corner of Sec. 23, being within the SE 1/4 SE 1/4
Donation land of Wm. W. Wood
(Name of person and bearing of section)
being within the S.W. corner of the 1 of Sec. 23 Twp. 9 S Rge. 4 W
(Smallest legal subdivision) (N. or S.) (E. or W.)

or (b) within limits of recorded platted property, town or city:

in Lot _____, Block _____ of _____
(Name of plat or addition)
County of _____
(If within city or town, give name)

3. Construction Work was begun on May 13, 1945; was completed on May 15, 1945
(Date) (Date)

and the ground water claimed was first used for the purposes set out below on May 30, 1945
(Date)

since which time the water has been used intermittently
(Continuously or intermittently)

from May to August
(Date) (Date)

4. Quantity of water claimed and used is 360 gallons per minute; 1 acre feet per year.

5. Purpose or Purposes for which water is used irrigation

(Domestic, irrigation, municipal, manufacturing, industrial, etc.)

6. Description of Well: Depth 30 feet. Type drilled
(Dug or drilled)

diameter 13 inches. Elevation of ground at well site 190 feet, mean sea level.
(As near as known)

Depth to water table 16 feet.

7. Capacity of Well: 360 g.p.m. with 10 feet drawdown.

_____ g.p.m. with _____ feet drawdown.


Date of test _____

If Flowing Well: Measured discharge _____ g.p.m. on _____
(Date)

Shut-in pressure at ground surface _____ lbs. per sq. in. on _____
(Date)

Water is controlled by _____
(Cap, valve, etc.)

Township 9 S Range 4 W W.M.
North

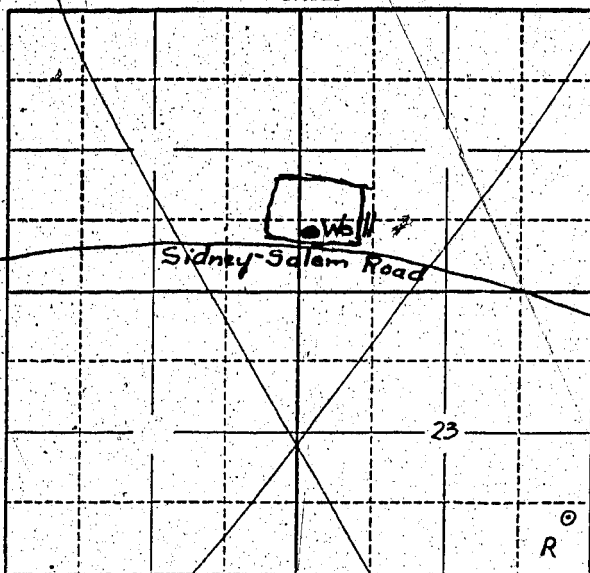

Locate well and acreage of irrigated land on plat.
Scale: 2" = 1 Mile

STATE OF OREGON

County of Marion } ss.

I, Ruby Hayden, being first duly sworn, do hereby certify that I have read the foregoing Registration Statement and that all of the items therein contained are true to the best of my knowledge and belief.

Ruby Hayden Trustee
(Signature of Registrant)

Subscribed and sworn to before me this 22nd day of July, 1958.

My commission expires Sept. 8, 1960

Chas. L. ...
(Notary Public)

(SEAL)

CERTIFICATE OF REGISTRATION

STATE OF OREGON } ss.
County of Marion

This is to certify that the foregoing Registration Statement was received in the office of the State Engineer on the 22nd day of July, 1958, at 10:30 o'clock A. M. and has been duly recorded in said office in Book No. 10 of Registration Statements on page GR-2362

Witness my hand this 10th day of March, 1959

Lewis A. Stanley
(State Engineer)

By _____
(Deputy)

#15-30

GR - 2362