

# Registration Statement

## OF CLAIMANT OF RIGHT TO APPROPRIATE GROUND WATER

TO THE STATE ENGINEER OF OREGON:

I, Pacific Mutual Life Insurance Company, P.O. Box 6050  
of Metropolitan Station, Los Angeles 55 County of Los Angeles.  
(Mailing address)

State of California, do hereby make application for a certificate of registration as evidence of a right to appropriate ground water.

1. Source from which water is withdrawn is pump well (Kress well)  
(Flowing well, pump well, infiltration trench, or tunnel)
2. Location is: in Salem, Marion County.  
(Approximate distance and direction from nearest city or town)

and is more particularly described as follows:

(a) About 1020 feet east & 100 feet North from SW corner Section 23,  
(Give distance and bearing to corner of section or other legal subdivision)  
being within SW 1/4 of S1/4 of Sec. 23, Twp. 7S, Rge. 3W  
(Smallest legal subdivision) (N. or S.) (E. or W.)

or (b) within limits of recorded platted property, town or city: 122' North of Center Street  
(Unplatted) (Acreage) And 131' East of Capitol Street  
in Lot \_\_\_\_\_, Block \_\_\_\_\_ of \_\_\_\_\_  
(Name of plat or addition)

Salem County of Marion.  
(If within city or town, give name)

3. Construction Work was begun on Sept. 1948; was completed on Oct. 1948  
(Date) (Date)

and the ground water claimed was first used for the purposes set out below, on 11/4/49  
(Date)

since which time the water has been used intermittantly  
(Continuously or intermittently)

from 11/4/49 to date of this registration.  
(Date) (Date)

4. Quantity of water claimed and used is 670 gallons per minute; 156 acre feet per year, based on 8 hours per day, 160 days per year.

5. Purpose or Purposes for which water is used Cooling air conditioning system,  
in stores on east side of Capitol St. bet. Center & Marion Streets  
(Domestic, irrigation, municipal, manufacturing, industrial, etc.)

6. Description of Well: Depth 216 feet. Type Drilled  
(Dug or drilled)

diameter 16 inches. Elevation of ground at well site 153' feet, mean sea level.  
Above is elevation of basement floor, or top of well  
Depth to water table 20 feet. Elevation of parking lot above is 167.5'.

7. Capacity of Well: 636 g.p.m. with 101 feet drawdown.  
550 g.p.m. with 87 feet drawdown.  
500 g.p.m. with 77 feet drawdown.  
400 g.p.m. with 70 feet drawdown.

Date of test Oct. 1949. 22 & 23.

If Flowing Well: Measured discharge \_\_\_\_\_ g.p.m. on \_\_\_\_\_  
(Date)


Shut-in pressure at ground surface \_\_\_\_\_ lbs. per sq. in. on \_\_\_\_\_  
(Date)

Water is controlled by \_\_\_\_\_  
(Cap. valve, etc.)





Township 75 Range 3W W.M.  
North

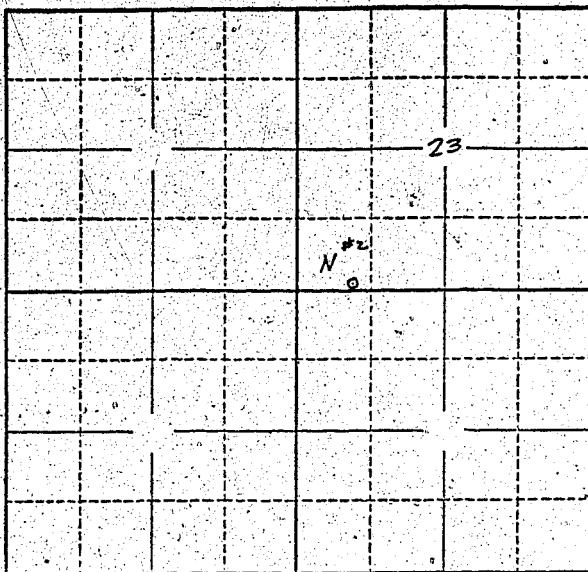

Locate well and acreage of irrigated land on plat.  
Scale: 2" = 1 Mile

STATE OF OREGON  
County of Marion

ss.

I, William Munroe Hamilton, being first duly sworn, do hereby certify that I have read the foregoing Registration Statement and that all of the items therein contained are true to the best of my knowledge and belief.

*William Munroe Hamilton*

(Signature of Registrant)

For Pacific Mutual Life Insurance Company.

Subscribed and sworn to before me this 21st day of July, 1958.

My commission expires MY COMMISSION EXPIRES JUNE 26, 1961

*W. W. Williams*

(Notary Public)

(SEAL)

**CERTIFICATE OF REGISTRATION**

STATE OF OREGON  
County of Marion

ss.

This is to certify that the foregoing Registration Statement was received in the office of the State Engineer on the 23rd day of July, 1958, at 10:00 o'clock A. M. and has been duly recorded in said office in Book No. 10 of Registration Statements on page GR-2364

Witness my hand this 10th day of March, 1959

*Levia A. Stanley*

(State Engineer)

By

(Deputy)

\$ 22.00

GR - 2364