

# Registration Statement

## OF CLAIMANT OF RIGHT TO APPROPRIATE GROUND WATER

TO THE STATE ENGINEER OF OREGON:

I, FORREST FREITAG

of R.T.L., BOX 94 JEFFERSON County of MARION

State of OREGON, do hereby make application for a certificate of registration as evidence of a right to appropriate ground water.

1. Source from which water is withdrawn is PUMP WELL  
(Flowing well, pump well, infiltration trench, or tunnel)

2. Location is: 9 MILE N.W. JEFFERSON  
(Approximate distance and direction from nearest city or town)

and is more particularly described as follows:

(a) WELL IS 528 FT. NORTH and 198 FT. WEST <sup>1/4 corner on S. Line sec 18</sup>  
(Give distance and bearing to corner of section or other legal subdivision)

being within SE/SW ~~44 Cor. on south line~~ of Sec. 18, Twp. 9 S., Rge. 3 W.  
(Smallest legal subdivision) (N. or S.) (E. or W.)

or (b) within limits of recorded platted property, town or city: \_\_\_\_\_

in Lot \_\_\_\_\_, Block \_\_\_\_\_ of \_\_\_\_\_  
(Name of plat or addition)

County of \_\_\_\_\_  
(If within city or town, give name)

3. Construction Work was begun on 1947; was completed on 1947  
(Date) (Date)

and the ground water claimed was first used for the purposes set out below on 1947  
(Date) (Estimate)

since which time the water has been used Int.  
(Continuously or intermittently)

from 1947 to 1957  
(Date) (Date)

4. Quantity of water claimed and used is ~~1600~~ 98 gallons per minute; 35.0 acre feet per year.

5. Purpose or Purposes for which water is used Irr.

(Domestic, irrigation, municipal, manufacturing, industrial, etc.)

6. Description of Well: Depth 45 feet. Type DRILLED  
(Dug or drilled)

diameter 10 inches. Elevation of ground at well site 180 feet, mean sea level.  
(As near as known)

Depth to water table 100 feet.

7. Capacity of Well: \_\_\_\_\_ g.p.m. with \_\_\_\_\_ feet drawdown.

\_\_\_\_\_ g.p.m. with \_\_\_\_\_ feet drawdown.

Date of test NOT TESTED

If Flowing Well: Measured discharge \_\_\_\_\_ g.p.m. on \_\_\_\_\_  
(Date)

Shut-in pressure at ground surface \_\_\_\_\_ lbs. per sq. in. on \_\_\_\_\_  
(Date)

Water is controlled by \_\_\_\_\_  
(Cap. valve, etc.)

8. Casing: (Give diameter, commercial specifications and depth below ground surface of each casing size.)

10" inch diameter 3/8" thick wall from 0 to 4.5 feet  
 inch diameter from to feet  
 inch diameter from to feet  
 inch diameter from to feet

Describe and show depth of shoe, plug, adapter, liner or other details:

9. Perforated Casings or Screens:

Cut by Torch about 3" wide from (unknown) to  
(Number per foot and size of perforations, or describe screen)  
 from to  
 from to  
 from to

10. Log of Well: (Describe each stratum or formation clearly, indicate if water bearing, and give thickness and depth as indicated.)

MATERIAL	Thickness (Feet)	Depth to Bottom (Feet)
soil	3	3
yellow clay	22	25
sand & gravel	20	45
clay started at 45'		

If log of well is not available, give name and address of driller. ....

11. Infiltration Trench: Covered or open .....

Dimensions: Length ..... ft. Minimum depth ..... ft. Maximum depth ..... ft.  
 Bottom width ..... ft. Discharge ..... g.p.m. Date of test .....

12. Tunnel: Type of lining .....

Dimensions: .....  
(Length, course, and cross sectional size)  
 Position of water bearing stratum with reference to portal of tunnel .....

Log of tunnel: (Preceding table for log of well may be used, if desired. Give footage from portal and character of materials, as pertinent.)

13. Pumping Equipment:


(a) Pump JACUZZI Jet Pump ..... Capacity about 98 g.p.m.  
(Make, type and size)  
 (b) Motor 5 HORSE POWER 1ϕ .....  
(Type and horsepower)

14. Location of area irrigated or to be irrigated, or place of use if for purposes other than irrigation.

Township North or South	Range E. or W. of Willamette Meridian	Section	Forty-acre Tract	Number Acres To Be Irrigated	Date of Reclamation
9 S	3 W	18	SE $\frac{1}{4}$ SW $\frac{1}{4}$	13.2	1947
"	"	"	NE $\frac{1}{4}$ SW $\frac{1}{4}$	1.1	1947
				<u>14.3 Ac.</u>	

15. If the ground water supply is supplemental to an existing water supply, identification of any application for a permit, permit, certificate or adjudicated right to appropriate water made or held by the registrant.

Township 9S Range 5W W.M.  
North

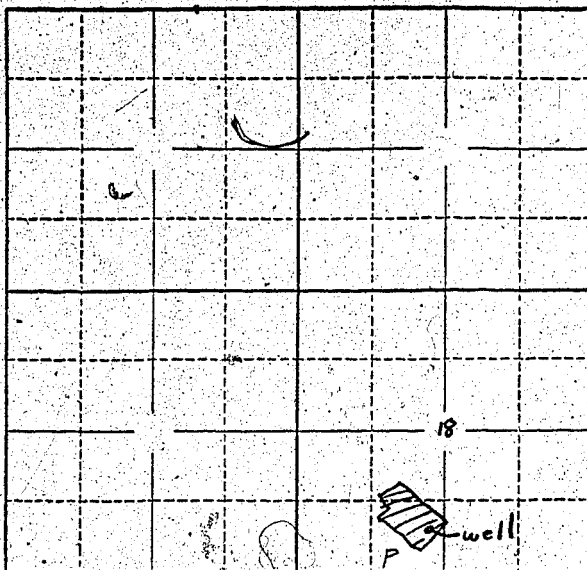

Locate well and acreage of irrigated land on plat.  
Scale: 2" = 1 Mile

STATE OF OREGON

County of Marion } ss.

I, Forrest Freitag, being first duly sworn, do hereby certify that I have read the foregoing Registration Statement and that all of the items therein contained are true to the best of my knowledge and belief.

Forrest Freitag  
(Signature of Registrant)

Subscribed and sworn to before me this 23 day of July, 1958

My commission expires Dec. 19, 1958 Daniel J. King  
(Notary Public)

(SEAL)

### CERTIFICATE OF REGISTRATION

STATE OF OREGON } ss.  
County of Marion

This is to certify that the foregoing Registration Statement was received in the office of the State Engineer on the 23rd day of July, 1958, at 8:45 o'clock A. M. and has been duly recorded in said office in Book No. 10 of Registration Statements on page GR-2365

Witness my hand this 10th day of March, 1959

Leura A. Stanley  
(State Engineer)

By \_\_\_\_\_  
(Deputy)

GR - 2365

\$ 1,500