

Registration Statement

OF CLAIMANT OF RIGHT TO APPROPRIATE GROUND WATER

(Under Chapter 708, Oregon Laws 1955.)

TO THE STATE ENGINEER OF OREGON:

I, Eugene Memorial Gardens, Inc.

of Eugene County of Lane

State of Oregon, do hereby make application for a certificate of registration as evidence of a right to appropriate ground water.

1. Source from which water is withdrawn is Pump well #1
(Flowing well, pump well, infiltration trench, or tunnel)

2. Location is: one mile south of Eugene
(Approximate distance and direction from nearest city or town)

and is more particularly described as follows: 1500 ft. South & 1490 ft. West from a subdivision of Sunset Hills Memorial Gardens NE cor. of Section 18.

(a) N 16° E 880 feet from SW corner of Garden of Devotion as
(Give distance and bearing to corner of section or other legal subdivision)

being within SW 1/4 of NE 1/4 of Sec. 18, Twp. 18 S, Rge. 5 W
(Smallest legal subdivision) (N. or S.) (E. or W.)

or (b) within limits of recorded platted property, town or city:

in Lot _____, Block _____ of _____
(Name of plat or addition)

County of _____
(If within city or town, give name)

3. Construction Work was begun on Summer, 1953; was completed on Summer, 1953
(Date) (Date)

and the ground water claimed was first used for the purposes set out below on Summer, 1953
(Date)

since which time the water has been used intermittently
(Continuously or intermittently)

from May to October
(Date) (Date)

4. Quantity of water claimed and used is 20 gallons per minute; 3/4 acre feet per year.

5. Purpose or Purposes for which water is used irrigation
(Domestic, irrigation, municipal, manufacturing, industrial, etc.)

6. Description of Well: Depth 390 feet. Type drilled
(Dug or drilled)

diameter eight inches. Elevation of ground at well site 540 feet, mean sea level.
(As near as known)

Depth to water table 80 - 100 feet.

7. Capacity of Well: 20 g.p.m. with 50 feet drawdown.

_____ g.p.m. with _____ feet drawdown.

Date of test 1953

If Flowing Well: Measured discharge _____ g.p.m. on _____
(Date)

Shut-in pressure at ground surface _____ lbs. per sq. in. on _____
(Date)

Water is controlled by _____
(Cap, valve, etc.)

8. Casing: (Give diameter, commercial specifications and depth below ground surface of each casing size.)

eight inch diameter standard steel pipe from (unknown) to feet
 inch diameter from to feet
 inch diameter from to feet
 inch diameter from to feet

Describe and show depth of shoe, plug, adapter, liner or other details:

9. Perforated Casings or Screens:

Unknown from to
 (Number per foot and size of perforations, or describe screen)
 from to
 from to
 from to

10. Log of Well: (Describe each stratum or formation clearly, indicate if water bearing, and give thickness and depth as indicated.)

MATERIAL	Thickness (Feet)	Depth to Bottom (Feet)
No log available		

If log of well is not available, give name and address of driller. Caesy Jones, Eugene, Oregon

11. Infiltration Trench: Covered or open
- Dimensions: Length ft. Minimum depth ft. Maximum depth ft.
- Bottom width ft. Discharge g.p.m. Date of test
12. Tunnel: Type of lining
- Dimensions:
(Length, course, and cross sectional size)
- Position of water bearing stratum with reference to portal of tunnel

Log of tunnel: (Preceding table for log of well may be used, if desired. Give footage from portal and character of materials, as pertinent.)


13. Pumping Equipment:
- (a) Pump Turbine, Fairbanks-Morse, 3-inch discharge Capacity 30 g.p.m.
(Make, type and size)
- (b) Motor 5 horsepower, three phase
(Type and horsepower)

14. Location of area irrigated or to be irrigated, or place of use if for purposes other than irrigation.

Township North or South	Range E. or W. of Willamette Meridian	Section	Forty-acre Tract	Number Acres To Be Irrigated	Date of Reclamation
<u>18 S</u>	<u>5 W</u>	<u>18</u>	<u>SW 1/4 of NE 1/4</u>	<u>ten</u>	<u>1953</u>
			<u>Five acres irrigated at the present time.</u>		

15. If the ground water supply is supplemental to an existing water supply, identification of any application for a permit, permit, certificate or adjudicated right to appropriate water made or held by the registrant.

Township 18S Range 3W W.M.
North

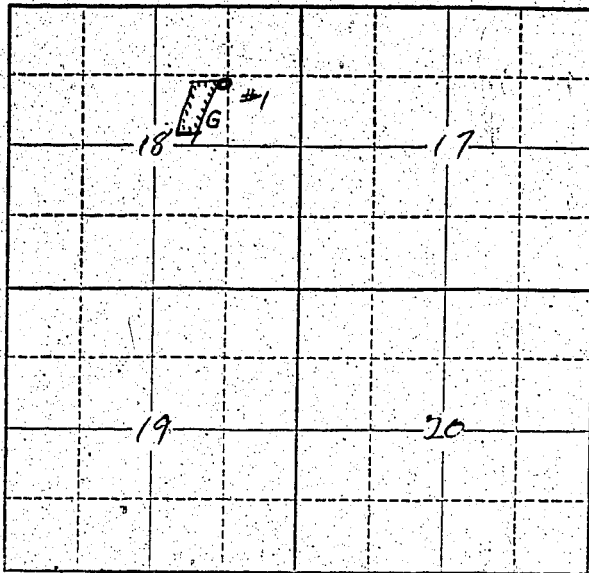

Locate well and acreage of irrigated land on plat.
Scale: 2" = 1 Mile

STATE OF OREGON

County of } ss.

I,, being first duly sworn, do hereby certify that I have read the foregoing Registration Statement and that all of the items therein contained are true to the best of my knowledge and belief.

Eugene Memorial Park
L. B. Gentry
.....
(Signature of Registrant)

Subscribed and sworn to before me this 22nd day of July, 1958

My commission expires September 22, 1958

Edward P. Johnson
.....
(Notary Public)

(SEAL)

CERTIFICATE OF REGISTRATION

STATE OF OREGON

County of Marion } ss.

This is to certify that the foregoing Registration Statement was received in the office of the State Engineer on the 23rd day of July, 1958, at 11.00 o'clock A. M. and has been duly recorded in said office in Book No. 10 of Registration Statements on page GR-2368

~~Construction started completed by and the water completely applied to
.....~~

Witness my hand this 10th day of March, 1959

Lewis A. Stanley
.....
(State Engineer)

#1500

By
(Deputy)

GR-2368