

Registration Statement

REGISTRATION NO. GR-2803
CERTIFICATE NO. GR-2370

OF CLAIMANT OF RIGHT TO APPROPRIATE GROUND WATER

(Under Chapter 708, Oregon Laws 1955.)

TO THE STATE ENGINEER OF OREGON:

I, Robert Roth
of Pt 2 Box 72 Silverton Ore County of Marion
State of Oregon, do hereby make application for a certificate of registration as evidence
of a right to appropriate ground water.

1. Source from which water is withdrawn is well
(Flowing well, pump well, infiltration trench, or tunnel)
2. Location is: 2 Miles N.W. Silverton
(Approximate distance and direction from nearest city or town)

and is more particularly described as follows:

(a) 400 Ft. west & 25 ft. south from NE corner section 28, T6S, R1W.
(Give distance and bearing to corner of section or other legal subdivision)
being within NE 1/4 of NE 1/4 of Sec. 28, Twp. 6S, Rge. 1W
(Smallest legal subdivision) (N. or S.) (E. or W.)

or (b) within limits of recorded platted property, town or city:

in Lot _____ Block _____ of _____
(Name of plat or addition)
County of Marion
(If within city or town, give name)

3. Construction Work was begun on Unknown; was completed on Unknown - 1948
(Date) (Date)
and the ground water claimed was first used for the purposes set out below on SEP. 1948
(Date)
since which time the water has been used Continuously - intermittently during season
(Continuously or intermittently)
from SEP. 1948 to July 1958
(Date) (Date)

4. Quantity of water claimed and used is 84 gallons per minute; 30 acre feet per year.

5. Purpose or Purposes for which water is used Domestic & Irrigation
(Domestic, irrigation, municipal, manufacturing, industrial, etc.)

6. Description of Well: Depth 100 feet. Type Drilled
(Dug or drilled)
diameter 8 inches. Elevation of ground at well site 144 feet, mean sea level.
(As near as known)
Depth to water table 20 feet.

7. Capacity of Well: 85 g.p.m. with Unknown feet drawdown.
_____ g.p.m. with _____ feet drawdown.


Date of test April 1954

If Flowing Well: Measured discharge No g.p.m. on _____
(Date)

Shut-in pressure at ground surface _____ lbs. per sq. in. on _____
(Date)

Water is controlled by _____
(Cap, valve, etc.)

Township 65 Range 1W, W.M.
North

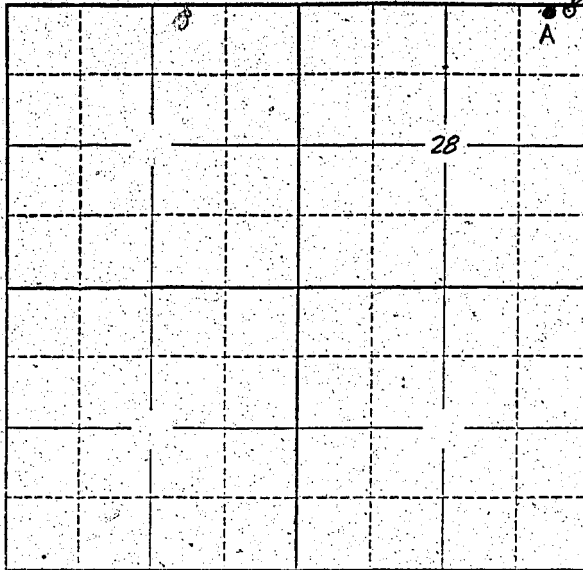

Locate well and acreage of irrigated land on plat.
Scale: 2" = 1 Mile.

STATE OF OREGON

County of Marion } ss.

I, _____, being first duly sworn, do hereby certify that I have read the foregoing Registration Statement and that all of the items therein contained are true to the best of my knowledge and belief.

Robert Roth
(Signature of Registrant)

Subscribed and sworn to before me this 23rd day of July, 1958

My commission expires 12th June 1961

Wm. S. Brattalovics
(Notary Public)

(SEAL)

CERTIFICATE OF REGISTRATION

STATE OF OREGON

County of Marion } ss.

This is to certify that the foregoing Registration Statement was received in the office of the State Engineer on the 23rd day of July, 1958, at 10:30 o'clock A. M. and has been duly recorded in said office in Book No. 10 of Registration Statements on page GR-2370

~~Construction shall be completed by _____ 19____, and the water completely applied to beneficial use by _____ 19____.~~

Witness my hand this 10th day of March, 1959

Henry A. Straley
(State Engineer)

By _____
(Deputy)

GR-2370

#15.00