

RECEIVED  
AUG 16 1956  
STATE ENGINEER  
SALEM, OREGON

Registration Statement

REGISTRATION NO. GR-251  
CERTIFICATE NO. GR-232

OF CLAIMANT OF RIGHT TO APPROPRIATE GROUND WATER

(Under Chapter 708, Oregon Laws 1955.)

TO THE STATE ENGINEER OF OREGON:


State of OREGON do hereby make application for a certificate of registration as evidence of a right to appropriate ground water.

1. Source from which water is withdrawn is PUMP WELL #1  
(Flowing well, pump well, infiltration trench, or tunnel)

2. Location is: 3 miles north of Harbor  
(Approximate distance and direction from nearest city or town)

and is more particularly described as follows:

(a) 60 feet east and 390 feet north from W. corner Section 15.  
A 7 A 28  
(Give distance and bearing to corner of section or other legal subdivision)

being within SW 1/4 of NW 1/4 of Sec. 15, Twp. 41S, Rge. 13W  
(Smallest legal subdivision) (E. or S.) (E. or W.)

or (b) within limits of recorded platted property, town or city:

in Lot \_\_\_\_\_ Block \_\_\_\_\_ of \_\_\_\_\_  
(Name of plat or addition)

County of \_\_\_\_\_  
(If within city or town, give name)

3. Construction Work was begun on 1955; was completed on 1955  
(Date) (Date)

and the ground water claimed was first used for the purposes set out below on July 14 1955  
(Date)

since which time the water has been used intermittent  
(Continuously or intermittently)

from July 14 1955 to date  
(Date) (Date)

4. Quantity of water claimed and used is 80 gallons per minute; \_\_\_\_\_ acre feet per year.

5. Purpose or Purposes for which water is used IRRIGATION 6.17 6.18 6.19  
FARM  
FERTILIZERS & OTHER CHEMICALS  
(Domestic, irrigation, municipal, manufacturing, industrial, etc.)

6. Description of Well: Depth 50 feet. Type drilled  
(Dug or drilled)

diameter 8" inches. Elevation of ground at well site 78 feet, mean sea level.  
(As near as known)

Depth to water table 30 feet.

7. Capacity of Well: 80 g.p.m. with \_\_\_\_\_ feet drawdown. limit of 150 g.p.m.  
electric pump  
\_\_\_\_\_ g.p.m. with \_\_\_\_\_ feet drawdown. generator

Date of test July 14 1955 by drill bucket

If Flowing Well: Measured discharge \_\_\_\_\_ g.p.m. on \_\_\_\_\_ (Date)

Shut-in pressure at ground surface \_\_\_\_\_ lbs. per sq. in. on \_\_\_\_\_ (Date)

Water is controlled by \_\_\_\_\_ (Cap, valve, etc.)

Capacity of well may be increased by larger pump when we get 3 phase electric power probably 1957



If log of well is not available, give name and address of driller L. J. Shannon

Francis P. Dwyer

11. Infiltration Trench: Covered or open \_\_\_\_\_

Dimensions: Length \_\_\_\_\_ ft. Minimum depth \_\_\_\_\_ ft. Maximum depth \_\_\_\_\_ ft.  
 Bottom width \_\_\_\_\_ ft. Discharge \_\_\_\_\_ g.p.m. Date of test \_\_\_\_\_

12. Tunnel: Type of lining \_\_\_\_\_

Dimensions: \_\_\_\_\_  
(Length, course, and cross sectional size)  
 Position of water bearing stratum with reference to portal of tunnel \_\_\_\_\_

Log of tunnel: (Preceding table for log of well may be used, if desired. Give footage from portal and character of materials, as pertinent.)

13. Pumping Equipment:

(a) Pump \_\_\_\_\_ Elect. Capacity 80 g.p.m.  
(Make, type and size)

(b) Motor \_\_\_\_\_ 5 Horse pump motor  
(Type and horsepower)

14. Location of area irrigated or to be irrigated, or place of use if for purposes other than irrigation.

Township North or South	Range E. or W. of Willamette Meridian	Section	Forty-acre Tract	Number Acres To Be Irrigated	Date of Reclamation
T41S	R13W	16	SE $\frac{1}{4}$ of NE $\frac{1}{4}$	1.00	July 1955
"	"	15	NW $\frac{1}{4}$ of NW $\frac{1}{4}$	.4	"
"	"	15	SW $\frac{1}{4}$ of NW $\frac{1}{4}$	20.00	"
"	"	15	NW $\frac{1}{4}$ of SW $\frac{1}{4}$	3.00	"
				24.4	

Warranty Deed


January 12, 1955

Book 43, page 731-2

A tract of land lying in Section 15, Township 41 South, Range 13 West, W.M., Curry County, Oregon: Beginning at a point which is South 2624.0 feet and West 17.9 feet from the Northwest corner of said Section 15, said point being also 10.0 feet Easterly, when measured at right angles, from the center line of the abandoned California Northern Railroad right of way;  
 Thence North 36 deg. 43 min. East 1755.2 feet;  
 Thence South 53 deg. 24 min. East 598.3 feet;  
 Thence South 37 deg. 20 min. West 519.6 feet;  
 Thence South 36 deg. 31 min. West 1264.5 feet;  
 Thence North 50 deg. 43 min. West 598.5 feet to the point of beginning.  
 Containing 24.21 acres, more or less.

15. If the ground water supply is supplemental to an existing water supply, identification of any application for a permit, permit, certificate or adjudicated right to appropriate water made or held by the registrant.

Township T41S Range 13 W, W.M.  
North

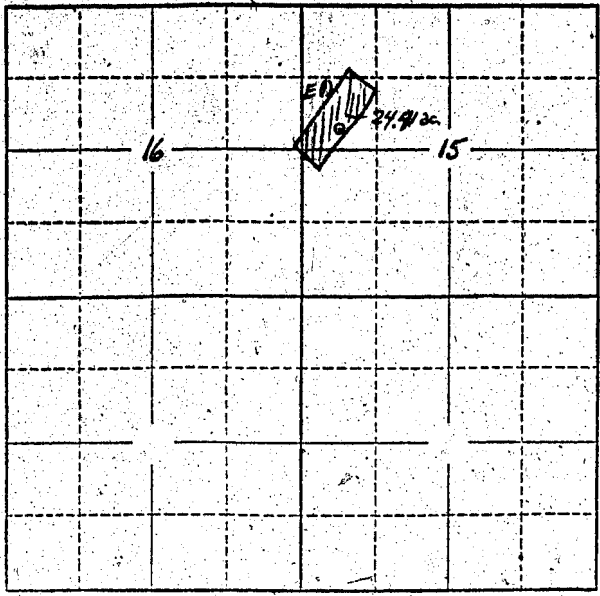

Attached.

Locate well and acreage of irrigated land on plat.  
Scale: 2" = 1 Mile

STATE OF OREGON }  
County of Curry } ss.

I, A.K. Hartung, being first duly sworn, do hereby certify that I have read the foregoing Registration Statement and that all of the items therein contained are true to the best of my knowledge and belief.

A.K. Hartung  
(Signature of Registrant)

Subscribed and sworn to before me this 14th day of August, 1956.

My commission expires April 19, 1960 Henry E. R...  
(Notary Public)

(SEAL)

**CERTIFICATE OF REGISTRATION**

STATE OF OREGON }  
County of Marion } ss.

This is to certify that the foregoing Registration Statement was received in the office of the State Engineer on the 5th day of September, 1956, at 2:45 o'clock P. M. and has been duly recorded in said office in Book No. 2 of Registration Statements on page GR-232 C.

~~Cancelled and returned to the registrant by the State Engineer on the 15th day of January, 1957.~~

Witness my hand this 15th day of January, 1957.

Lawis A. Stanley  
(State Engineer)

By \_\_\_\_\_  
(Deputy)

GR-232 C