

RECEIVED
JUL 29 1958
STATE ENGINEER
SALEM OFFICE

Registration Statement

REGISTRATION NO. GR-251
CERTIFICATE NO. OR-2378

SALEM OFFICE OF CLAIMANT OF RIGHT TO APPROPRIATE GROUND WATER

(Under Chapter 708, Oregon Laws 1955.)

TO THE STATE ENGINEER OF OREGON:

I, A. E. BODEKER

of CORVALLIS County of BENTON

State of OREGON, do hereby make application for a certificate of registration as evidence of a right to appropriate ground water.

1. Source from which water is withdrawn is Pump well
(Flowing well, pump well, infiltration trench, or tunnel)

2. Location is: 4 miles northeast of Corvallis
(Approximate distance and direction from nearest city or town)

and is more particularly described as follows:

(a) 10.0 chains S. 48° E. of the southwest corner of the Mary Sylvester DLC #47
(Give distance and bearing to corner of section or other legal subdivision)

being within SE₄ of the SW₂ of Sec. 18, Twp. 11 S., Rge. 4 W.
(Smallest legal subdivision) (N. or S.) (E. or W.)

or (b) within limits of recorded platted property, town or city:

in Lot _____, Block _____ of _____
(Name of plat or addition)

County of _____
(If within city or town, give name)

3. Construction Work was begun on 1924; was completed on _____
(Date) (Date)

and the ground water claimed was first used for the purposes set out below on 1924
(Date)

since which time the water has been used continuously
(Continuously or Intermittently)

from 1924 to date
(Date) (Date)

4. Quantity of water claimed and used is 180 gallons per minute; _____ acre feet per year.

5. Purpose or Purposes for which water is used irrigation

(Domestic, irrigation, municipal, manufacturing, industrial, etc.)

6. Description of Well: Depth 60 feet. Type drilled
(Dug or drilled)

diameter 8 inches. Elevation of ground at well site 250 feet, mean sea level.
(As near as known)

Depth to water table 15 feet. average

7. Capacity of Well: _____ g.p.m. with _____ feet drawdown. unknown

_____ g.p.m. with _____ feet drawdown.


Date of test _____

If Flowing Well: Measured discharge _____ g.p.m. on _____
(Date)

Shut-in pressure at ground surface _____ lbs. per sq. in. on _____
(Date)

Water is controlled by _____
(Cap, valve, etc.)

Township 11.5 Range 4W, W.M.
North

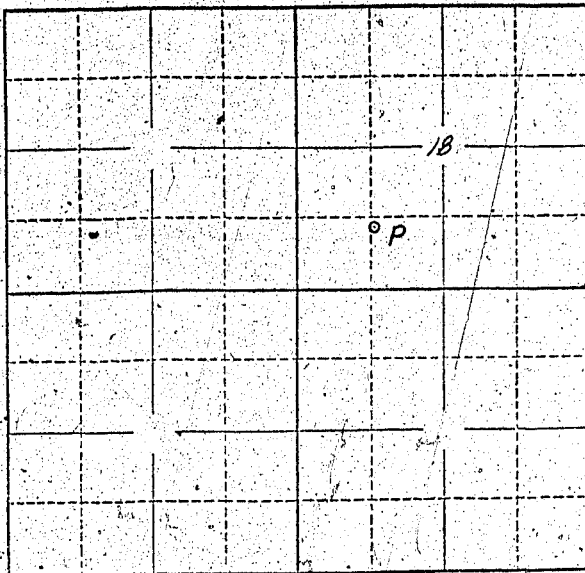

Locate well and acreage of irrigated land on plat.
Scale: 2" = 1 Mile

STATE OF OREGON
County of BENTON } ss.

I, A. E. BODERER, being first duly sworn, do hereby certify that I have read the foregoing Registration Statement and that all of the items therein contained are true to the best of my knowledge and belief.

A. E. Boderer
(Signature of Registrant)

Subscribed and sworn to before me this 21st day of July, 1958

My commission expires April 11, 1962
R. E. Banning
(Notary Public)

(SEAL)

CERTIFICATE OF REGISTRATION

STATE OF OREGON
County of Marion } ss.

This is to certify that the foregoing Registration Statement was received in the office of the State Engineer on the 23 day of July, 1958, at 8:00 o'clock A. M. and has been duly recorded in said office in Book No. 10 of Registration Statements on page GR-2378

~~Conservation shall be maintained by the State Engineer and the water completely impounded hereafter by the State Engineer.~~

Witness my hand this 10th day of March, 1959
Henry A. Stanley
(State Engineer)

By _____ (Deputy)
GR-2378

#1500