

Registration Statement

OF CLAIMANT OF RIGHT TO APPROPRIATE GROUND WATER

TO THE STATE ENGINEER OF OREGON:

#2
I, Mr. MAX A CRAMER AND SARAH KIM CRAMER

of 5185 Madrona Lane, Medford County of Jackson

(Mailing address)

State of Oregon, do hereby make application for a certificate of registration as evidence of a right to appropriate ground water.

1. Source from which water is withdrawn is PUMP WELL #2
(Flowing well, pump well, infiltration trench, or tunnel)

2. Location is: Approx. three miles West of Medford Jackson County Oregon
(Approximate distance and direction from nearest city or town)

and is more particularly described as follows:

(a) 147' South & 853' West from the SE cor. DLG # 75
(Give distance and bearing to corner of section or other legal subdivision)

being within NW 1/4 NW 1/4 (DCL78) of Sec. 35, Twp. 37 South, Rge. 2 West of W.M.
(Smallest legal subdivision) (N. or S.) (E. or W.)

or (b) within limits of recorded platted property, town or city:

in Lot _____, Block _____ of _____
(Name of plat or addition)

(If within city or town, give name)

County of _____

3. Construction Work was begun on July 1946; was completed on July 1946
(Date) (Date)

and the ground water claimed was first used for the purposes set out below on July 1946
(Date)

since which time the water has been used continuously
(Continuously or intermittently)

from July 1946 to date of application July 1958
(Date) (Date)

4. Quantity of water claimed and used is TEN gallons per minute; 5.0 acre feet per year.

5. Purpose or Purposes for which water is used IRRIGATION
~~Domestic lawn and orchard sprinkling and water for stock and poultry~~
(Domestic, irrigation, municipal, manufacturing, industrial, etc.)

6. Description of Well: Depth 55 feet feet. Type drilled
(Dug or drilled)
diameter 8" casing inches. Elevation of ground at well site approx. 1500' feet, mean sea level.
(As near as known)
Depth to water table 12' feet.

7. Capacity of Well: _____ g.p.m. with _____ feet drawdown.

_____ g.p.m. with _____ feet drawdown.


Date of test 7-15-1958

If Flowing Well: Measured discharge _____ g.p.m. on _____
(Date)

Shut-in pressure at ground surface _____ lbs. per sq. in. on _____
(Date)

Water is controlled by _____
(Cap, valve, etc.)

Township 37S Range 2W, W.M.
North

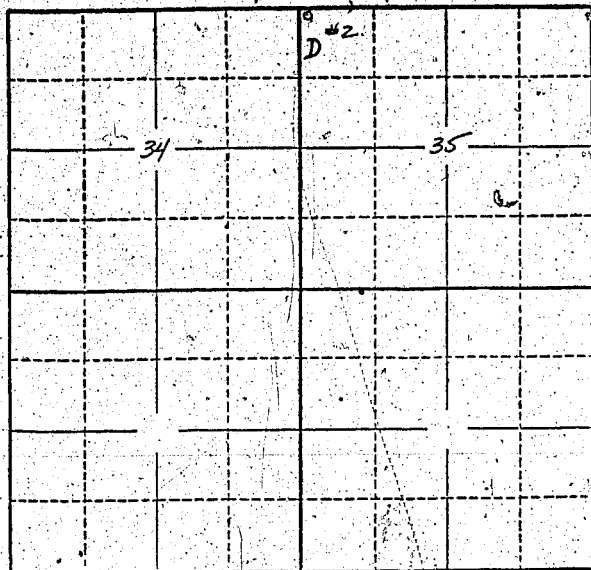

Locate well and acreage of irrigated land on plat.
Scale: 2" = 1 Mile

STATE OF OREGON

County of Washington } ss.

I, MAX J. CRAMER of SIOUX KIM CRAMER, being first duly sworn, do hereby certify that I have read the foregoing Registration Statement and that all of the items therein contained are true to the best of my knowledge and belief.

Max J. Cramer
Sioux Kim Cramer
(Signature of Registrant)

Subscribed and sworn to before me this 23rd day of July, 1958.

My commission expires May 27 1959 _____
(Notary Public)

(SEAL)

CERTIFICATE OF REGISTRATION

STATE OF OREGON } ss.
County of Marion

This is to certify that the foregoing Registration Statement was received in the office of the State Engineer on the 23 day of July, 1958, at 8:00 o'clock A. M. and has been duly recorded in said office in Book No. _____ of Registration Statements on page GR-2380.

Witness my hand this 10th day of March, 1959

Luvs A. Stanley
(State Engineer)

By _____
(Deputy)