

# Registration Statement

RECEIVED  
JUL 2 1955  
STATE ENGINEER  
SALEM OREGON

## OF CLAIMANT OF RIGHT TO APPROPRIATE GROUND WATER

TO THE STATE ENGINEER OF OREGON:

I, Leo Charles and Frances E. Martin

of 920 Tolman Rd., Ashland County of Jackson  
(Mailing address)

State of Oregon do hereby make application for a certificate of registration as evidence of a right to appropriate ground water.

1. Source from which water is withdrawn is pump well  
(Flowing well, pump well, infiltration trench, or tunnel)
2. Location is: 1 1/2 miles Southeast of Ashland, Oregon  
(Approximate distance and direction from nearest city or town)

and is more particularly described as follows:

(a) 380 feet North and 548 feet West from the center of Section 14  
(Give distance and bearing to corner of section or other legal subdivision)  
being within SE 1/4 SE 1/4 NW 1/4 of Sec. 14 Twp. 39S Rge. 1E  
(Smallest legal subdivision) (N. or S.) (E. or W.)

or (b) within limits of recorded platted property, town or city:

in Lot \_\_\_\_\_ Block \_\_\_\_\_ of \_\_\_\_\_  
(Name of plat or addition)  
County of \_\_\_\_\_  
(If within city or town, give name)

3. Construction Work was begun on April 7, 1955; was completed on April 9, 1955  
(Date) (Date)

and the ground water claimed was first used for the purposes set out below on April 1955  
(Date)

since which time the water has been used continuously  
(Continuously or intermittently)  
from April 1955 to present  
(Date) (Date)

4. Quantity of water claimed and used is 8.0 gallons per minute; 3.0 acre feet per year.

5. Purpose ~~of~~ Purposes for which water is used Supplemental Irrigation  
(Domestic, irrigation, municipal, manufacturing, industrial, etc.)

6. Description of Well: Depth 46 feet. Type Drilled  
(Dug or drilled)  
diameter 6.0 inches. Elevation of ground at well site 2080 feet, mean sea level.  
(As near as known)  
Depth to water table 3.5 feet.

7. Capacity of Well: \_\_\_\_\_ g.p.m. with \_\_\_\_\_ feet drawdown.  
\_\_\_\_\_ g.p.m. with \_\_\_\_\_ feet drawdown.

Date of test none

If Flowing Well: Measured discharge \_\_\_\_\_ g.p.m. on \_\_\_\_\_  
(Date)

Shut-in pressure at ground surface \_\_\_\_\_ lbs. per sq. in. on \_\_\_\_\_  
(Date)

Water is controlled by \_\_\_\_\_  
(Cap, valve, etc.)

8. Casing: (Give diameter, commercial specifications and depth below ground surface of each casing size.)

6.0 inch diameter steel casing from 0 to 23 feet  
inch diameter from to feet  
inch diameter from to feet  
inch diameter from to feet

Describe and show depth of shoe, plug, adapter, liner or other details:

9. Perforated Casings or Screens:

none from to  
(Number per foot and size of perforations, or describe screen)  
from to  
from to  
from to

10. Log of Well: (Describe each stratum or formation clearly, indicate if water bearing, and give thickness and depth as indicated.)

MATERIAL	Thickness (Feet)	Depth to Bottom (Feet)
Top soil	22	21
Brown shale	17	7
Blue shale (water bearing)	7	0

If log of well is not available, give name and address of driller. Dallas S. DeLap - 749 Eagle Mill Rd., Ashland, Oregon

11. Infiltration Trench: Covered or open

Dimensions: Length \_\_\_\_\_ ft. Minimum depth \_\_\_\_\_ ft. Maximum depth \_\_\_\_\_ ft.  
Bottom width \_\_\_\_\_ ft. Discharge \_\_\_\_\_ g.p.m. Date of test \_\_\_\_\_

12. Tunnel: Type of lining

Dimensions: \_\_\_\_\_  
(Length, course, and cross sectional size)  
Position of water bearing stratum with reference to portal of tunnel \_\_\_\_\_

Log of tunnel: (Preceding table for log of well may be used, if desired. Give footage from portal and character of materials, as pertinent.)

13. Pumping Equipment:


(a) Pump 1" x 3/4" Reciprocating Pump (Durno) Capacity 8.0 g.p.m.  
(Make, type and size)  
(b) Motor 1/3 H.P. electric motor  
(Type and horsepower)

14. Location of area irrigated or to be irrigated, or place of use if for purposes other than irrigation.

Township North or South	Range E. or W. of Willamette Meridian	Section	Forty-acre Tract	Number Acres To Be Irrigated	Date of Reclamation
39 S	1 E	14	SE $\frac{1}{4}$ SE $\frac{1}{4}$ NW $\frac{1}{4}$	1.01 acres	April 1955

15. If the ground water supply is supplemental to an existing water supply, identification of any application for a permit, permit, certificate or adjudicated right to appropriate water made or held by the registrant. This to be supplemental to the rights of the Talent Irrigation District

Township 39 S Range 1 E, W.M.  
North

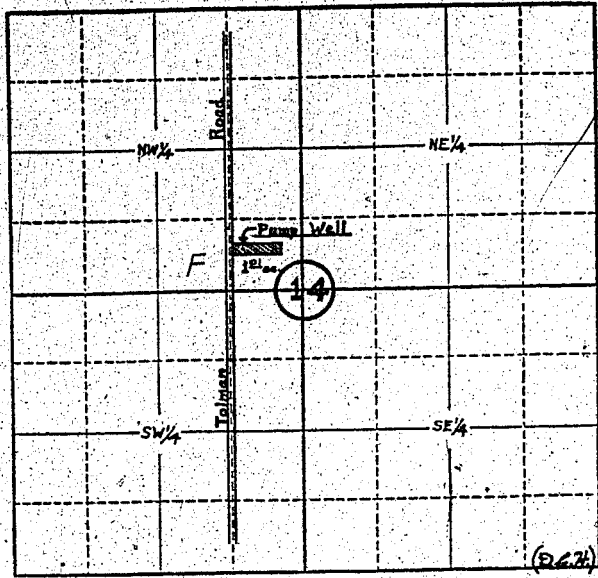

Locate well and acreage of irrigated land on plat.  
Scale: 4" = 1 Mile

STATE OF OREGON }  
County of Jackson } ss.

I, \_\_\_\_\_, being first duly sworn, do hereby certify that I have read the foregoing Registration Statement and that all of the items therein contained are true to the best of my knowledge and belief.

Leo Charles Martin  
Louise E. Martin  
(Signature of Registrant)

Subscribed and sworn to before me this 27 day of July, 1958

My commission expires July 1, 1960 Paul C. Brown  
(Notary Public)

(SEAL)

**CERTIFICATE OF REGISTRATION**

STATE OF OREGON }  
County of Marion } ss.

This is to certify that the foregoing Registration Statement was received in the office of the State Engineer on the 23 day of July, 1958, at 8:00 o'clock A. M. and has been duly recorded in said office in Book No. 10 of Registration Statements on page GR-2382

Witness my hand this 10<sup>th</sup> day of March, 1959

Laura A. Stanley  
(State Engineer)

\$1500

By \_\_\_\_\_ (Deputy)

GR - 2382