

Registration Statement

OF CLAIMANT OF RIGHT TO APPROPRIATE GROUND WATER

TO THE STATE ENGINEER OF OREGON:

I, James R. Wabbe

of Route 1 Box 260 Eugene County of Lane
(Mailing address)

State of Oregon, do hereby make application for a certificate of registration as evidence of a right to appropriate ground water.

1. Source from which water is withdrawn is Pump Well #2
(Flowing well, pump well, infiltration trench, or tunnel)

2. Location is: 5 Mile North West of Eugene
(Approximate distance and direction from nearest city)

and is more particularly described as follows:

(a) 1280' West and 140 Feet South of Center of Section 18
(Give distance and bearing to corner of section or other legal subdivision)

being within NE 1/4 of SW 1/4 of Sec. 18, Twp. 17S, Rge. 4W
(Smallest legal subdivision) (of S.) (of W.)

or (b) within limits of recorded platted property, town or city:

in Lot _____, Block _____ of _____
(Name of plat or addition)

County of _____
(If within city or town, give name)

3. Construction Work was begun on 1952; was completed on 1952
(Date) (Date)

and the ground water claimed was first used for the purposes set out below on 1952
(Date)

since which time the water has been used Intermittently
(Continuously or intermittently)

from 1952 to July 1958
(Date) (Date)

4. Quantity of water claimed and used is 30 gallons per minute; 2 1/2 acre feet per year.

5. Purpose or Purposes for which water is used _____

Exempt Irrigation
(Domestic, irrigation, municipal, manufacturing, industrial, etc.)

6. Description of Well: Depth 60 feet. Type Dug
(Dug or drilled)

diameter 5 inches. Elevation of ground at well site 300 feet, mean sea level.
(As near as known)

Depth to water table 5 feet.

7. Capacity of Well: 50 g.p.m. with 1.0 feet drawdown.

_____ g.p.m. with _____ feet drawdown.


Date of test No test

If Flowing Well: Measured discharge _____ g.p.m. on _____
(Date)

Shut-in pressure at ground surface _____ lbs. per sq. in. on _____
(Date)

Water is controlled by _____
(Cap, valve, etc.)

Township 178 Range 4W W.M.
North

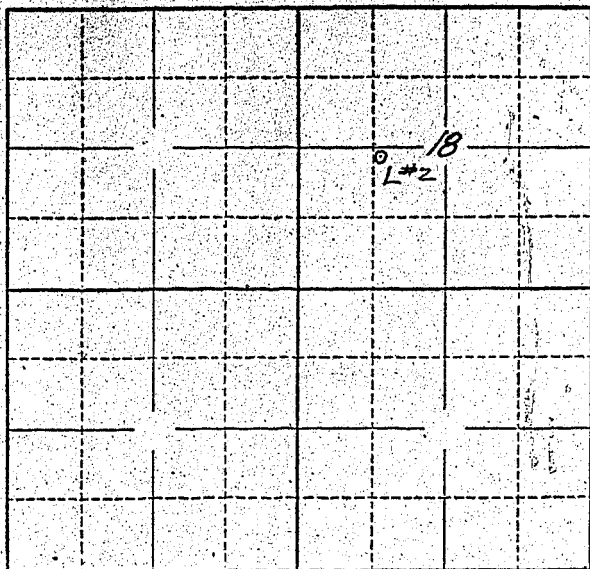

Locate well and acreage of irrigated land on plat.
Scale: 2" = 1 Mile

STATE OF OREGON

County of Lane } ss.

I, James R. Wobbe, being first duly sworn, do hereby certify that I have read the foregoing Registration Statement and that all of the items therein contained are true to the best of my knowledge and belief.

James R. Wobbe
(Signature of Registrant)

Subscribed and sworn to before me this 22 day of July, 1958

My commission expires March 2, 1962

Burt W. Gay
(Notary Public)

(SEAL)

CERTIFICATE OF REGISTRATION

STATE OF OREGON

County of Marion } ss.

This is to certify that the foregoing Registration Statement was received in the office of the State Engineer on the 23 day of July, 1958, at 8:00 o'clock A. M. and has been duly recorded in said office in Book No. 10 of Registration Statements on page GR-2386

Witness my hand this 10th day of March, 1959

Lewis A. Stanley
(State Engineer)

By _____ (Deputy)

\$1500