

Registration Statement

OF CLAIMANT OF RIGHT TO APPROPRIATE GROUND WATER

TO THE STATE ENGINEER OF OREGON:

I, A. C. Zinser

of Box 77, Coburg, Oregon County of Lane

State of Oregon, do hereby make application for a certificate of registration as evidence of a right to appropriate ground water.

1. Source from which water is withdrawn is Pump Well #1
(Flowing well, pump well, infiltration trench, or tunnel)

2. Location is: West portino of Coburg, Oregon
(Approximate distance and direction from nearest city or town)

and is more particularly described as follows:

(a) S. 1250' W. 1155' from the N. E. corner
(Give distance and bearing to corner of section or other legal subdivision)

being within NE 1/4 NE 1/4 of Sec. 32, Twp. 16 S, Rge. 3 W
(Smallest legal subdivision) (N. or S.) (E. or W.)

or (b) within limits of recorded platted property, town or city: _____

in Lot _____, Block _____ of _____
(Name of plat or addition)

County of _____
(If within city or town, give name)

3. Construction Work was begun on 1934; was completed on 1934
(Date) (Date)

and the ground water claimed was first used for the purposes set out below on 1934
(Date)

since which time the water has been used intermittently
(Continuously or Intermittently)

from May to October each year
(Date) (Date)

4. Quantity of water claimed and used is 360 gallons per minute; 38 acre feet per year.

5. Purpose or Purposes for which water is used Irrigation

(Domestic, irrigation, municipal, manufacturing, industrial, etc.)

6. Description of Well: Depth 20 feet Type Driven
(Dug or drilled)

diameter 3 - 2" pipes inches. Elevation of ground at well site 390' feet, mean sea level.
(As near as known)

Depth to water table 15 feet. Approximately

7. Capacity of Well: _____ g.p.m. with _____ feet drawdown.

_____ g.p.m. with _____ feet drawdown.

Date of test No actual test made

If Flowing Well: Measured discharge _____ g.p.m. on _____
(Date)


Shut-in pressure at ground surface _____ lbs. per sq. in. on _____
(Date)

Water is controlled by _____
(Cap, valve, etc.)

See attached map

Township 16.5 Range 3W, W.M.

North

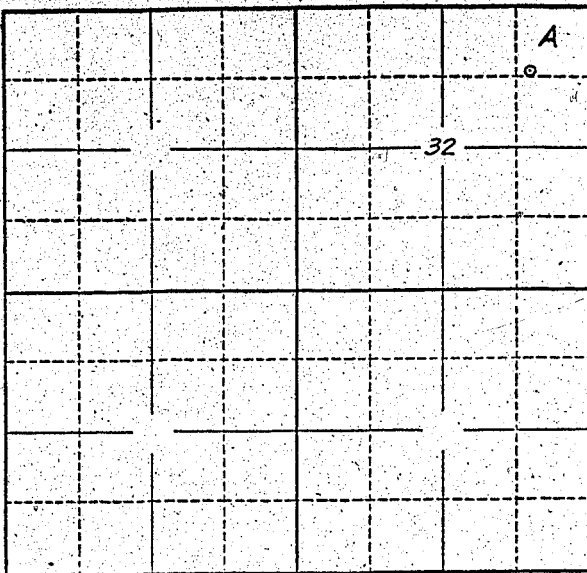

Locate well and acreage of irrigated land on plat.

Scale: 2" = 1 Mile

STATE OF OREGON

County of Lane } ss.

I, A. C. Zinser being first duly sworn, do hereby certify that I have read the foregoing Registration Statement and that all of the items therein contained are true to the best of my knowledge and belief.

A. C. Zinser
(Signature of Registrant)

Subscribed and sworn to before me this 23rd day of July, 1958.

My commission expires August 13, 1958

Wm. W. Dell
(Notary Public)
Notary Public for Oregon.

(SEAL)

CERTIFICATE OF REGISTRATION

STATE OF OREGON

County of Marion } ss.

This is to certify that the foregoing Registration Statement was received in the office of the State Engineer on the 23 day of July, 1958, at 8:00 o'clock A. M. and has been duly recorded in said office in Book No. 10 of Registration Statements on page GR-2388

Witness my hand this 10th day of March, 1959.

Lewis A. Stanley
(State Engineer)

By _____ (Deputy)

\$15.00