

Registration Statement

OF CLAIMANT OF RIGHT TO APPROPRIATE GROUND WATER

TO THE STATE ENGINEER OF OREGON:

I, Marvel L. and Opal G. Cooley

of 2105 E. Queen Avenue, Albany County of Linn
(Mailing address)

State of Oregon, do hereby make application for a certificate of registration as evidence of a right to appropriate ground water.

1. Source from which water is withdrawn is Dump well
(Flowing well, pump well, infiltration trench, or tunnel)

2. Location is: 1/2 mile E. of Albany Oregon
(Approximate distance and direction from nearest city or town)

and is more particularly described as follows:

(a) 2035' N. and 2244' W. of SE corner S. 8, T. 11S., R. 3W.
(Give distance and bearing to corner of section or other legal subdivision)
being within NW 1/4 of SE 1/4 of Sec. 8, Twp. 11S., Rge. 3 W.
(Smallest legal subdivision) (N. or S.) (E. or W.)

or (b) within limits of recorded platted property, town or city:

in Lot _____, Block _____ of _____
(Name of plat or addition)
County of Linn
(If within city or town, give name)

3. Construction Work was begun on March 1949; was completed on March 1949
(Date) (Date)

and the ground water claimed was first used for the purposes set out below on May 1949
(Date)

since which time the water has been used Continuously
(Continuously or intermittently)

from May 1949 to present time
(Date) (Date)

4. Quantity of water claimed and used is 48 gallons per minute; 60.0 acre feet per year.

5. Purpose or Purposes for which water is used Irrigation

(Domestic, irrigation, municipal, manufacturing, industrial, etc.)

6. Description of Well: Depth 89 feet. Type drilled
(Dug or drilled)

diameter 8 inches. Elevation of ground at well site 200 feet, mean sea level.
(As near as known)

Depth to water table 35 feet.

7. Capacity of Well: _____ g.p.m. with _____ feet drawdown.

_____ g.p.m. with _____ feet drawdown.

Date of test Not tested

If Flowing Well: Measured discharge _____ g.p.m. on _____
(Date)

Shut-in pressure at ground surface _____ lbs. per sq. in. on _____
(Date)

Water is controlled by _____
(Cap, valve, etc.)

8. Casing: (Give diameter, commercial specifications and depth below ground surface of each casing size.)

8 inch diameter Steel casing from 0 to 75 feet
 inch diameter from to feet
 inch diameter from to feet
 inch diameter from to feet

Describe and show depth of shoe, plug, adapter, liner or other details:

9. Perforated Casings or Screens:


Slot perforations from 77 to 89
 (Number per foot and size of perforations, or describe screen)
 from to
 from to
 from to

10. Log of Well: (Describe each stratum or formation clearly, indicate if water bearing, and give thickness and depth as indicated.)

MATERIAL	Thickness (Feet)	Depth to Bottom (Feet)
Clay	13	13
Conglomerate	6	19
Water gravel	4	23
Gravel and clay	26	49
Water bearing gravel	6	55
Blue clay	10	65
Blue gravel - sand streaks of clay - good water	10	75
Sandy clay	14	89

Township 11 S Range 3 W. W.M.

North

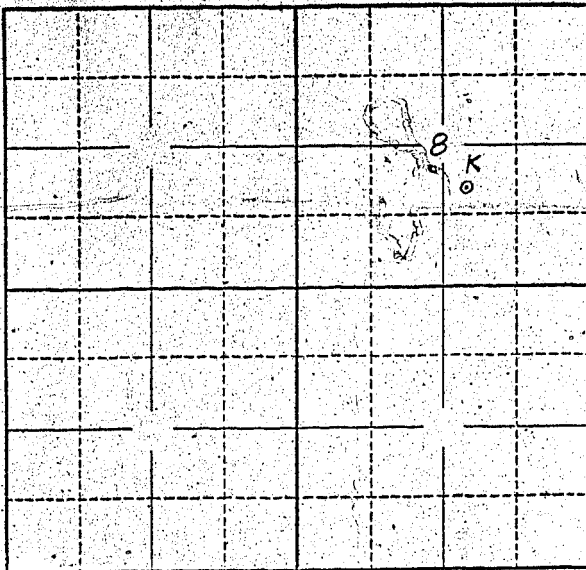

Locate well and acreage of irrigated land on plat.

Scale: 2" = 1 Mile

STATE OF OREGON

County of Linn

} ss.

I, Marvell, and Opal G. Cooley, being first duly sworn, do hereby certify that I have read the foregoing Registration Statement and that all of the items therein contained are true to the best of my knowledge and belief.

Mr. Cooley
Mrs. Opal G. Cooley
 (Signature of Registrant)

Subscribed and sworn to before me this 30th day of July, 1958

NOTARY PUBLIC FOR OREGON

My commission expires My Commission Expires March 31, 1961

[Signature]
 (Notary Public)

(SEAL)

CERTIFICATE OF REGISTRATION

STATE OF OREGON

County of Marion

} ss.

This is to certify that the foregoing Registration Statement was received in the office of the State Engineer on the 23 day of July, 1958, at 8:00 o'clock A. M. and has been duly recorded in said office in Book No. 10 of Registration Statements on page GR-2390

Witness my hand this 10th day of March, 1959

Laura A. Stanley
 (State Engineer)

\$15.00

By _____ (Deputy)