

# Registration Statement

## OF CLAIMANT OF RIGHT TO APPROPRIATE GROUND WATER

TO THE STATE ENGINEER OF OREGON:

I, Rolland Lamp

of Route 1, Shedd County of Linn  
(Mailing address)

State of Oregon, do hereby make application for a certificate of registration as evidence of a right to appropriate ground water.

1. Source from which water is withdrawn is pump well  
(Flowing well, pump well, infiltration trench, or tunnel)

2. Location is: 4 1/2 miles NW of Shedd, Oregon  
(Approximate distance and direction from nearest city or town)

and is more particularly described as follows:

(a) 2376' S. and 891' E. of NW corner S.34, T.12S, R.4W.  
(Give distance and bearing to corner of section or other legal subdivision)

being within SW 1/4 of NW 1/4 of Sec. 34, Twp. 12S, Rge. 4W  
(Smallest legal subdivision) (N. or S.) (E. or W.)

or (b) within limits of recorded platted property, town or city:

in Lot \_\_\_\_\_, Block \_\_\_\_\_ of \_\_\_\_\_  
(Name of plat or addition)

County of Linn  
(If within city or town, give name)

3. Construction Work was begun on 1954; was completed on 1954  
(Date) (Date)

and the ground water claimed was first used for the purposes set out below on June, 1954  
(Date)

since which time the water has been used Intermittently  
(Continuously or intermittently)

from June, 1954 to present time  
(Date) (Date)

4. Quantity of water claimed and used is 210 gallons per minute; 225.0 acre feet per year.

5. Purpose or Purposes for which water is used Irrigation

(Domestic, irrigation, municipal, manufacturing, industrial, etc.)

6. Description of Well: Depth 121 feet. Type Drilled  
(Dug or drilled)

diameter 8 inches. Elevation of ground at well site 285 feet, mean sea level.  
(As near as known)

Depth to water table 27 feet.

7. Capacity of Well: 385 g.p.m. with 80 feet drawdown.

\_\_\_\_\_ g.p.m. with \_\_\_\_\_ feet drawdown.

Date of test June, 1954

If Flowing Well: Measured discharge \_\_\_\_\_ g.p.m. on \_\_\_\_\_  
(Date)


Shut-in pressure at ground surface \_\_\_\_\_ lbs. per sq. in. on \_\_\_\_\_  
(Date)

Water is controlled by \_\_\_\_\_  
(Cap. valve, etc.)





Township 12S Range 4W, W.M.  
North

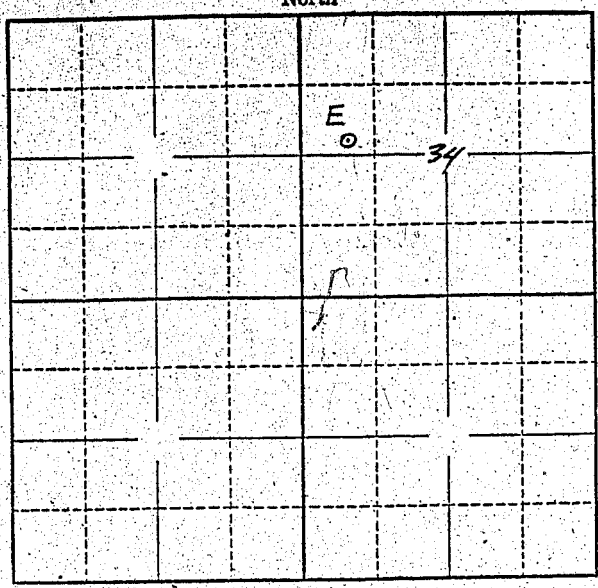

Locate well and acreage of irrigated land on plat.  
Scale: 2" = 1 Mile

STATE OF OREGON  
County of Linn } ss.

I, Rolland Lamp, being first duly sworn, do hereby certify that I have read the foregoing Registration Statement and that all of the items therein contained are true to the best of my knowledge and belief.

*Rolland Lamp*  
(Signature of Registrant)

Subscribed and sworn to before me this 22nd day of July, 1958

My commission expires MY COMMISSION EXPIRES MAY 22, 1962  
(Notary Public)

(SEAL)

**CERTIFICATE OF REGISTRATION**

STATE OF OREGON } ss.  
County of Marion

This is to certify that the foregoing Registration Statement was received in the office of the State Engineer on the 23<sup>rd</sup> day of July, 1958, at 8:00 o'clock A.M. and has been duly recorded in said office in Book No. 10 of Registration Statements on page GR-2391

Witness my hand this 10<sup>th</sup> day of March, 1959  
*Laura A. Stanley*  
(State Engineer)

\$21.75

By \_\_\_\_\_ (Deputy)

GR-2391