

Registration Statement

OF CLAIMANT OF RIGHT TO APPROPRIATE GROUND WATER

TO THE STATE ENGINEER OF OREGON:

I, Georgie C. Mitchell

of Route 2, Box 181, Lebanon
(Mailing address)

County of Linn

State of Oregon, do hereby make application for a certificate of registration as evidence of a right to appropriate ground water.

1. Source from which water is withdrawn is Pump well No. 1
(Flowing well, pump well, infiltration trench, or tunnel)

2. Location is: 2 miles N. of Lebanon, Oregon
(Approximate distance and direction from nearest city or town)

and is more particularly described as follows:

(a) S. 74° W. 10.8 chains from NE corner SE $\frac{1}{4}$, S. 34, T. 11S., R. 2W.
(Give distance and bearing to corner of section or other legal subdivision)
being within NE $\frac{1}{4}$ of SE $\frac{1}{4}$ of Sec. 34, Twp. 11S., Rge. 2W.
(Smallest legal subdivision) (N. or S.) (E. or W.)

or (b) within limits of recorded platted property, town or city:

in Lot _____, Block _____ of _____
(Name of plat or addition)

County of Linn
(If within city or town, give name)

3. Construction Work was begun on March 1951; was completed on March 1951
(Date) (Date)

and the ground water claimed was first used for the purposes set out below on July, 1951
(Date)

since which time the water has been used Continuously
(Continuously or intermittently)

from July 1, 1951 to present time
(Date) (Date)

4. Quantity of water claimed and used is 750 gallons per minute; 198.3 acre feet per year.

5. Purpose or Purposes for which water is used Irrigation

(Domestic, irrigation, municipal, manufacturing, industrial, etc.)

6. Description of Well: Depth 26 feet. Type Drilled
(Dug or drilled)

diameter 10 inches. Elevation of ground at well site 320 feet, mean sea level.
(As near as known)

Depth to water table 14 feet.

7. Capacity of Well: _____ g.p.m. with _____ feet drawdown.

_____ g.p.m. with _____ feet drawdown.


Date of test Not tested

If Flowing Well: Measured discharge _____ g.p.m. on _____
(Date)

Shut-in pressure at ground surface _____ lbs. per sq. in. on _____
(Date)

Water is controlled by _____
(Cap, valve, etc.)

Township 11 S. Range 2 W., W.M.
North

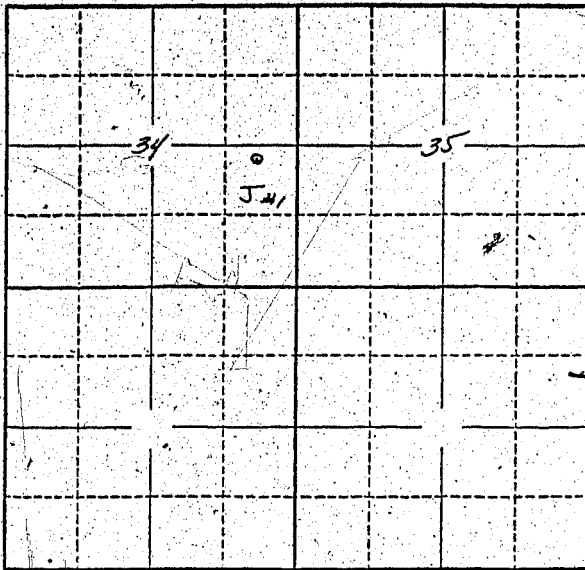

Locate well and acreage of irrigated land on plat.
Scale: 2" = 1 Mile

STATE OF OREGON

County of Linn } ss.

I, George C. Mitchell, being first duly sworn, do hereby certify that I have read the foregoing Registration Statement and that all of the items therein contained are true to the best of my knowledge and belief.

George Mitchell
(Signature of Registrant)

Subscribed and sworn to before me this 16th day of July, 1958.

My commission expires September 21, 1960.

Wm. J. ...
(Notary Public) for Oregon.

(SEAL)

CERTIFICATE OF REGISTRATION

STATE OF OREGON

County of Marion } ss.

This is to certify that the foregoing Registration Statement was received in the office of the State Engineer on the 23 day of July, 1958, at 8:00 o'clock A. M. and has been duly recorded in said office in Book No. 10 of Registration Statements on page GR-2392

Witness my hand this 10th day of March, 1959

Lewis A. Stanley
(State Engineer)

By _____ (Deputy)

\$ 20.55

GR-2392