

Registration Statement

OF CLAIMANT OF RIGHT TO APPROPRIATE GROUND WATER

TO THE STATE ENGINEERS OF OREGON:

I, Georgie C. Mitchell
of Route 2, Box 181, Lebanon County of Linn
(Mailing address)

State of Oregon do hereby make application for a certificate of registration as evidence of a right to appropriate ground water,

1. Source from which water is withdrawn is Pump well No. 2
(Flowing well, pump well, infiltration trench, or tunnel)

2. Location is: 2 miles North of Lebanon, Oregon
(Approximate distance and direction from nearest city or town)

and is more particularly described as follows:

(a) N. 72°10' E. 14.3 chains from SW corner of NW 1/4, S. 35, T. 11S, R. 2W
(Give distance and bearing to corner of section or other legal subdivision)
being within SW 1/4 of NW 1/4 of Sec. 35, Twp. 11 S, Rge. 2 W
(Smallest legal subdivision) (N. or S.) (E. or W.)

or (b) within limits of recorded platted property, town or city:

in Lot _____, Block _____ of _____
(Name of plat or addition)
County of Linn
(If within city or town, give name)

3. Construction Work was begun on July 1951; was completed on July 1951
(Date) (Date)

and the ground water claimed was first used for the purposes set out below on July 1951
(Date)

since which time the water has been used Continuously
(Continuously or intermittently)

from July 1951 to present time
(Date) (Date)

4. Quantity of water claimed and used is 350 gallons per minute; 184.2 acre feet per year.

5. Purpose or Purposes for which water is used Irrigation

(Domestic, irrigation, municipal, manufacturing, industrial, etc.)

6. Description of Well: Depth 32 feet. Type drilled
(Dug or drilled)

diameter 10 inches. Elevation of ground at well site 315 feet mean sea level.
(As near as known)

Depth to water table 14 feet.

7. Capacity of Well: _____ g.p.m. with _____ feet drawdown.

_____ g.p.m. with _____ feet drawdown.


Date of test Not tested

If Flowing Well: Measured discharge _____ g.p.m. on _____
(Date)

Shut-in pressure at ground surface _____ lbs. per sq. in. on _____
(Date)

Water is controlled by _____
(Cap, valve, etc.)

Township 11 S Range 2 W W.M.
North

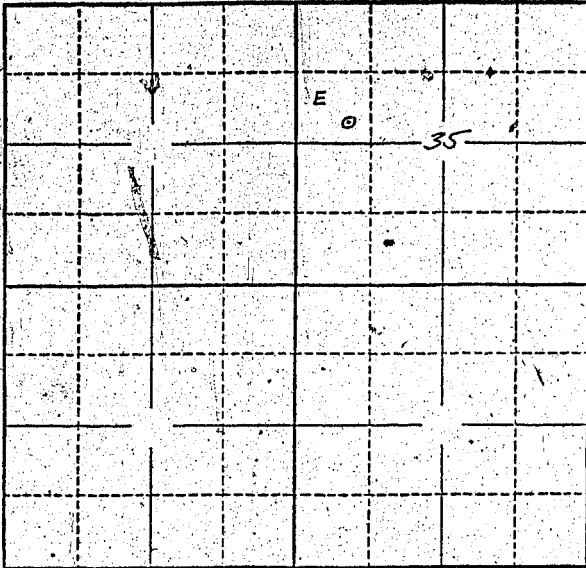

Locate well and acreage of irrigated land on plat:
Scale: 2" = 1 Mile

STATE OF OREGON

County of Linn } ss.

I, Georgie C. Mitchell, being first duly sworn, do hereby certify that I have read the foregoing Registration Statement and that all of the items therein contained are true to the best of my knowledge and belief.

Georgie Mitchell
(Signature of Registrant)

Subscribed and sworn to before me this 16th day of July, 1958.

My commission expires September 21, 1960

Thos. Truesler
(Notary Public) for Oregon.

(SEAL)

CERTIFICATE OF REGISTRATION

STATE OF OREGON

County of Marion } ss.

This is to certify that the foregoing Registration Statement was received in the office of the State Engineer on the 23 day of July, 1958, at 8:00 o'clock A. M. and has been duly recorded in said office in Book No. 10 of Registration Statements on page GR 2393.

Witness my hand this 10th day of March, 1959

Lewis J. Stanley
(State Engineer)

\$19.80

By _____ (Deputy)

GR - 2393