

Registration Statement

OF CLAIMANT OF RIGHT TO APPROPRIATE GROUND WATER

TO THE STATE ENGINEER OF OREGON:

I, Ferry Roth

of Rt. 2, Box 328, Albany County of Linn

State of Oregon, do hereby make application for a certificate of registration as evidence of a right to appropriate ground water.

1. Source from which water is withdrawn is Pump Well # 2
(Flowing well, pump well, infiltration trench, or funnel)
2. Location is: 10 mi. North of Albany, Oregon
(Approximate distance and direction from nearest city or town)

and is more particularly described as follows:

(a) 1221' S and 130' W. of NW corner of NE $\frac{1}{4}$ of S. 11, T. 10 S., R. 1 W.
(Give distance and bearing to corner of section or other legal subdivision)

being within NW $\frac{1}{4}$ of NE $\frac{1}{4}$ of Sec. 11, Twp. 10 S., Rge. 1 W.
(Smallest legal subdivision) (N. or S.) (E. or W.)

or (b) within limits of recorded platted property, town or city:
in Lot _____, Block _____ of _____
(Name of plat or addition)

County of Linn
(If within city or town, give name)

3. Construction Work was begun on May 1953; was completed on May 1953
(Date) (Date)

and the ground water claimed was first used for the purposes set out below on June 1953
(Date)
since which time the water has been used intermittently
(Continuously or intermittently)

from June 1953 to present time
(Date) (Date)

4. Quantity of water claimed and used is 360 gallons per minute; 108.0 acre feet per year.

5. Purpose or Purposes for which water is used Irrigation

(Domestic, irrigation, municipal, manufacturing, industrial, etc.)

6. Description of Well: Depth 32 feet. Type Drilled
(Dug or drilled)

diameter 10 inches. Elevation of ground at well site 160 feet, mean sea level.
(As near as known)

Depth to water table 10 feet.

7. Capacity of Well: _____ g.p.m. with _____ feet drawdown.

_____ g.p.m. with _____ feet drawdown.


Date of test Not Tested

If Flowing Well: Measured discharge _____ g.p.m. on _____
(Date)

Shut-in pressure at ground surface _____ lbs. per sq. in. on _____
(Date)

Water is controlled by _____
(Cap. valve, etc.)

Township 10 S Range 4 W, W.M.
North

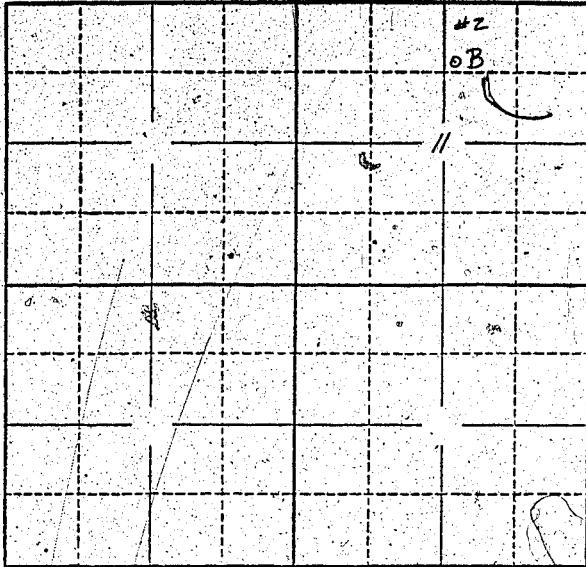

Locate well and acreage of irrigated land on plat.
Scale: 2" = 1 Mile

STATE OF OREGON }
County of LINN } ss.

I, Perry Roth being first duly sworn, do hereby certify that I have read the foregoing Registration Statement and that all of the items therein contained are true to the best of my knowledge and belief.

(Signature of Registrant)

Subscribed and sworn to before me this 22nd day of July, 1955.

My commission expires MY COMMISSION EXPIRES MAY 22, 1962
(Notary Public)

(SEAL)

CERTIFICATE OF REGISTRATION

STATE OF OREGON }
County of Marion } ss.

This is to certify that the foregoing Registration Statement was received in the office of the State Engineer on the 23 day of July, 1955, at 8:00 o'clock A. M. and has been duly recorded in said office in Book No. 10 of Registration Statements on page GR-2395

Witness my hand this 16th day of March, 1959.

Lewis A. Petrucci
(State Engineer)

By _____
(Deputy)

\$15.00

GR - 2395