

Registration Statement

OF CLAIMANT OF RIGHT TO APPROPRIATE GROUND WATER

TO THE STATE ENGINEER OF OREGON:

I, Hutoguan N. Linegar or Carl E. Linegar

of Route 4 Box 327 Corvallis Oregon County of Linn

State of Oregon, do hereby make application for a certificate of registration as evidence of a right to appropriate ground water.

- 1. Source from which water is withdrawn is Pomp Well #4
(Flowing well, pump well, infiltration trench, or spring)
- 2. Location is: 1 1/2 miles east of Corvallis - north of Albany Road
(Approximate distance and direction from nearest city or town)

and is more particularly described as follows:

(a) S 68° W 1145 feet from SE corner DLC #87
(Give distance and bearing to corner of section or other legal subdivision)

being within SE 1/4 of SW 1/4 of Sec. 31, Twp. 11 S, Rge. 4 W
(Smallest legal subdivision) (N or S.) (E or W.)

or (b) within limits of recorded platted property, town or city:

in Lot _____, Block _____ of _____
(Name of plat or addition)

_____ County of _____
(If within city or town, give name)

3. Construction Work was begun on May 1950; was completed on June 3, 1950
(Date)

and the ground water claimed was first used for the purposes set out below on June 1st 1950
(Date)

since which time the water has been used intermittently during season
(Continuously or intermittently)

from May to Oct. 1957
(Date)

4. Quantity of water claimed and used is 2.2 C gallons per minute; _____ acre feet per year.

5. Purpose or Purposes for which water is used Irrigation
(Domestic, irrigation, municipal, manufacturing, industrial, etc.)

6. Description of Well: Depth 32 feet. Type Drilled
(Dug or drilled)

diameter 14 inches. Elevation of ground at well site approx 224 feet, mean sea level.
(As near as known)

Depth to water table 12 to 28 feet. depending on time of year being Pumped

7. Capacity of Well: Over 400 g.p.m. with 4 to 12 feet drawdown. dependent on time of year

_____ g.p.m. with _____ feet drawdown.

Date of test Tested only by Pumping for irrigation

If Flowing Well: Measured discharge _____ g.p.m. on _____
(Date)

Shut-in pressure at ground surface _____ lbs. per sq. in. on _____
(Date)

Water is controlled by _____
(Cap, valve, etc.)

8. Casing: (Give diameter, commercial specifications and depth below ground surface of each casing size.)

14 inch diameter *steel casing* from 0 to 32 feet
 inch diameter from to feet
 inch diameter from to feet
 inch diameter from to feet

Describe and show depth of shoe, plug, adapter, liner or other details: _____

9. Perforated Casings or Screens:

(Number per foot and size of perforations, or describe screen) _____ from _____ to _____
 _____ from _____ to _____
 _____ from _____ to _____
 _____ from _____ to _____

10. Log of Well: (Describe each stratum or formation clearly, indicate if water bearing, and give thickness and depth as indicated.)

MATERIAL	Thickness (Feet)	Depth to Bottom (Feet)
<i>sand & gravel from top surface to bottom very similar for full depth</i>		

If log of well is not available, give name and address of driller. *Frank Killings*
address unknown at this time

11. Infiltration Trench: Covered or open
Dimensions: Length ft. Minimum depth ft. Maximum depth ft.

Bottom width ft. Discharge g.p.m. Date of test

12. Tunnel: Type of lining

Dimensions:
(Length, course, and cross sectional size)

Position of water bearing stratum with reference to portal of tunnel

Log of tunnel: (Preceding table for log of well may be used, if desired. Give footage from portal and character of materials, as pertinent.)


13. Pumping Equipment: *Centrifugal*
(a) Pump *Fairbanks Morse* *10 H.P.* Capacity *350* g.p.m.
(Make, type and size)
(b) Motor *3450 R.P.M. - 10 H.P.*
(Type and horsepower)

14. Location of area irrigated or to be irrigated, or place of use if for purposes other than irrigation.

Township North or South	Range E. or W. of Willamette Meridian	Section	Forty-acre Tract	Number Acres To Be Irrigated	Date of Reclamation
<i>T11S</i>	<i>R4W</i>	<i>31</i>	<i>SE 1/4 of SW 1/4</i>	<i>32.6 AC</i>	<i>1950</i>

15. If the ground water supply is supplemental to an existing water supply, identification of any application for a permit, permit, certificate or adjudicated right to appropriate water made or held by the registrant.

Township 11 S Range 4 W W.M.
North

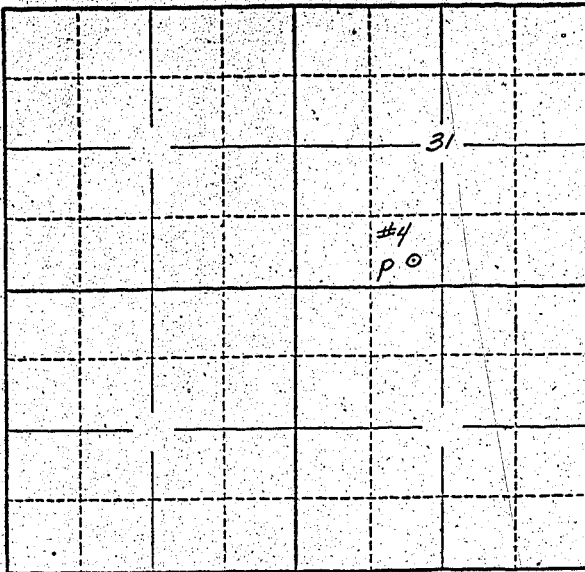

Locate well and acreage of irrigated land on plat.
Scale: 2" = 1 Mile

STATE OF OREGON }
County of BENTON } ss.

I, CARL E. LINEGAR being first duly sworn, do hereby certify that I have read the foregoing Registration Statement and that all of the items therein contained are true to the best of my knowledge and belief.

Carl E. Linegar
(Signature of Registrant)

Subscribed and sworn to before me this 21 day of July, 1958

My commission expires 4-8-62

Jamieson Walton
(Notary Public)

(SEAL)

CERTIFICATE OF REGISTRATION

STATE OF OREGON }
County of Marion } ss.

This is to certify that the foregoing Registration Statement was received in the office of the State Engineer on the 23 day of July, 1958, at 8:00 o'clock A. M. and has been duly recorded in said office in Book No. 10 of Registration Statements on page GR-2398

Witness my hand this 16th day of March, 1959

#15.45

Laura A. Stanley
(State Engineer)

By _____
(Deputy)