

Registration No. GR 2547

Certificate No. GR 2407

Registration Statement

OF CLAIMANT OF RIGHT TO APPROPRIATE GROUND WATER

TO THE STATE ENGINEER OF OREGON:

I, Chas K. McCormack, Secretary, Cloverdale Farms, Inc.
of P.O. Box 392, Albany County of Linn
(Mailing address)
State of Oregon, do hereby make application for a certificate of registration as evidence of a right to appropriate ground water.

1. Source from which water is withdrawn is PUMP WELL Golf Course #3
(Flowing well, pump well, infiltration trench, or tunnel)

2. Location is: 1/4 mile north of the City of Albany, Oregon
(Approximate distance and direction from nearest city or town)

and is more particularly described as follows:

(a) 1333 ft W and 1023 S from the center of Sed 6, T 11 S, R 3 W, W. 9E
(Give distance and bearing to corner of section or other legal subdivision)
being within NW 1/4 of the SW 1/4 of Sec. 6, Twp. 11 S, Rge. 3 W
(Smallest legal subdivision) (N. or S.) (E. or W.)

or (b) within limits of recorded platted property, town or city:

in Lot _____, Block _____ of _____
(Name of plat or addition)
County of _____
(If within city or town, give name)

3. Construction Work was begun on 1941; was completed on 1941
(Date) (Date)

and the ground water claimed was first used for the purposes set out below on July 1, 1950
(Date)

since which time the water has been used intermittently
(Continuously or intermittently)
from 7/1/50 to _____ date
(Date) (Date)

4. Quantity of water claimed and used is 1000 gallons per minute; _____ acre feet per year.

5. Purpose or Purposes for which water is used irrigation

(Domestic, irrigation, municipal, manufacturing, industrial, etc.)

6. Description of Well: Depth 36 feet. Type DRILLED
(Dug or drilled)

diameter 16" inches. Elevation of ground at well site 190 feet, mean sea level.
(As near as known)

Depth to water table 9 feet.

7. Capacity of Well: 1000 g.p.m. with 1 feet drawdown.

_____ g.p.m. with _____ feet drawdown.

Date of test 1941

If Flowing Well: Measured discharge _____ g.p.m. on _____
(Date)

Shut-in pressure at ground surface _____ lbs. per sq. in. on _____
(Date)

Water is controlled by _____
(Cap, valve, etc.)

8. Casing: (Give diameter, commercial specifications and depth below ground surface of each casing size.)

8 inch diameter STEEL from 0 to 36 feet
inch diameter from to feet
inch diameter from to feet
inch diameter from to feet

Describe and show depth of shoe, plug, adapter, liner or other details:
.....
.....

9. Perforated Casings or Screens:

6 PER FOOT 3/8" X 8" from 19 to 28
(Number per foot and size of perforations, or describe screen)
..... from to
..... from to
..... from to

10. Log of Well: (Describe each stratum or formation clearly, indicate if water bearing, and give thickness and depth as indicated.)

MATERIAL	Thickness (Feet)	Depth to Bottom (Feet)


11. Infiltration Trench: Covered or open

Dimensions: Length ft. Minimum depth ft. Maximum depth ft.

Bottom width ft. Discharge g.p.m. Date of test

12. Tunnel: Type of lining

Dimensions: (Length, course, and cross sectional size)

Position of water bearing stratum with reference to portal of tunnel

Log of tunnel; (Preceding table for log of well may be used, if desired. Give footage from portal and character of materials, as pertinent.)

13. Pumping Equipment:

(a) Pump 25HP Centrifugal Capacity 1000 g.p.m.
(Make, type and size)


(b) Motor 25 HP GAS ENGINE
(Type and horsepower)

14. Location of area irrigated or to be irrigated, or place of use if for purposes other than irrigation.

Township North or South	Range E. or W. of Willamette Meridian	Section	Forty-acre Tract	Number Acres To Be Irrigated	Date of Reclamation
11 S	3 W	6	NE $\frac{1}{4}$ of NW $\frac{1}{4}$	12 100	1944 1950
11 S	3 W	6	SE $\frac{1}{4}$ of NW $\frac{1}{4}$	40 140	"
11 S	3 W	6	SW $\frac{1}{4}$ of NW $\frac{1}{4}$	5 140	"
11 S	3 W	6	NW $\frac{1}{4}$ of SW $\frac{1}{4}$	20 140	"
11 S	3 W	6	NE $\frac{1}{4}$ of SW $\frac{1}{4}$	30 140	"
11 S	3 W	6	NW $\frac{1}{4}$ of SE $\frac{1}{4}$	6 140	"
11 S	3 W	6	SW $\frac{1}{4}$ of NE $\frac{1}{4}$	6 140	"
				120 = Total	

15. If the ground water supply is supplemental to an existing water supply, identification of any application for a permit, permit, certificate or adjudicated right to appropriate water made or held by the registrant.

Township 11 S Range 3 W, W.M.
North

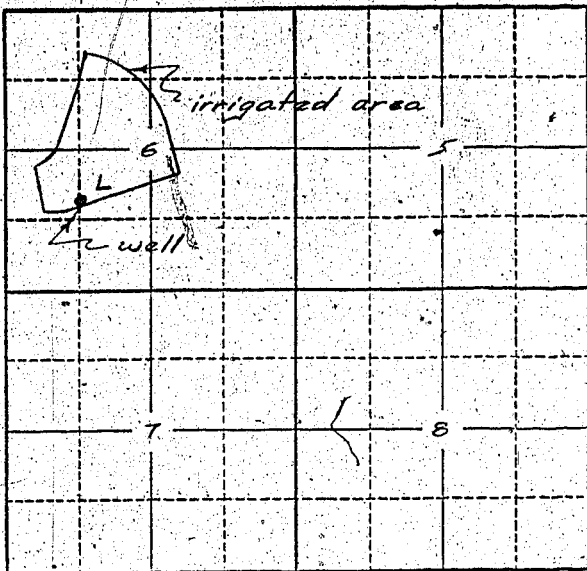

Locate well and acreage of irrigated land on plat.
Scale: 2" = 1 Mile

STATE OF OREGON

County of Linn

ss.

I, Chas. K. McCormick, being first duly sworn, do hereby certify that I have read the foregoing Registration Statement and that all of the items therein contained are true to the best of my knowledge and belief.

Chas. K. McCormick, Secretary
Chenabale Farms, Inc.
(Signature of Registrant)

Subscribed and sworn to before me this 22nd day of July, 1958.

My commission expires 12th June 1961

Wm. J. Bartholomew
(Notary Public)

(SEAL)

CERTIFICATE OF REGISTRATION

STATE OF OREGON

County of Marion

ss.

This is to certify that the foregoing Registration Statement was received in the office of the State Engineer on the 23rd day of July, 1958, at 1:00 o'clock P. M. and has been duly recorded in said office in Book No. 10 of Registration Statements on page GR-2407

Witness my hand this 16th day of March, 1959

Lewis A. Stanley
(State Engineer)

By

(Deputy)

GR-2407

\$26.50