

6 R 2550

Registration Statement

OF CLAIMANT OF RIGHT TO APPROPRIATE GROUND WATER

(Under Chapter 708, Oregon Laws 1955.)

RECEIVED
JULY 11 1951
STATE ENGINEER
GAINES DIVISION

TO THE STATE ENGINEER OF OREGON:

I, J. E. Dusterhoit
of Act 1 B 176 Eagle Point County of Jackson
State of Oregon, do hereby make application for a certificate of registration as evidence
of a right to appropriate ground water.

1. Source from which water is withdrawn is pump well
(Flowing well, pump well, infiltration trench, or tunnel)

2. Location is: _____
(Approximate distance and direction from nearest city or town)

and is more particularly described as follows:

(a) 560 feet north and 1100 feet west from E 1/4 corner Section 8
(Give distance and bearing to corner of section or other legal subdivision)

being within SE 1/4 of NE 1/4 of Sec. 8, Twp. 36 S, Rge. 1 W
(Smallest legal subdivision) (N. or S.) (E. or W.)

or (b) within limits of recorded platted property, town or city: _____

in Lot _____, Block _____ of _____
(Name of plat or addition)

_____ County of _____
(If within city or town, give name)

3. Construction Work was begun on Aug 13 1951; was completed on Aug 10 1951
(Date) (Date)

and the ground water claimed was first used for the purposes set out below on Aug 20 1951
(Date)

since which time the water has been used seasonally
(Continuously or Intermittently)

from 1951 to 1958
(Date) (Date)

4. Quantity of water claimed and used is 75 gallons per minute; _____ acre
feet per year.

5. Purpose or Purposes for which water is used irrigation

(Domestic, irrigation, municipal, manufacturing, industrial, etc.)

6. Description of Well: Depth 150 feet. Type drilled
(Dug or drilled)

diameter 6 inches. Elevation of ground at well site 1400 feet, mean sea level.
(As near as known)

Depth to water table 30 feet.

7. Capacity of Well: 75 g.p.m. with 100 feet drawdown.

_____ g.p.m. with _____ feet drawdown.


Date of test 10 51

If Flowing Well: Measured discharge _____ g.p.m. on _____
(Date)

Shut-in pressure at ground surface _____ lbs. per sq. in. on _____
(Date)

Water is controlled by _____
(Cap, valve, etc.)

Township 36 S Range 1 W W.M.
North

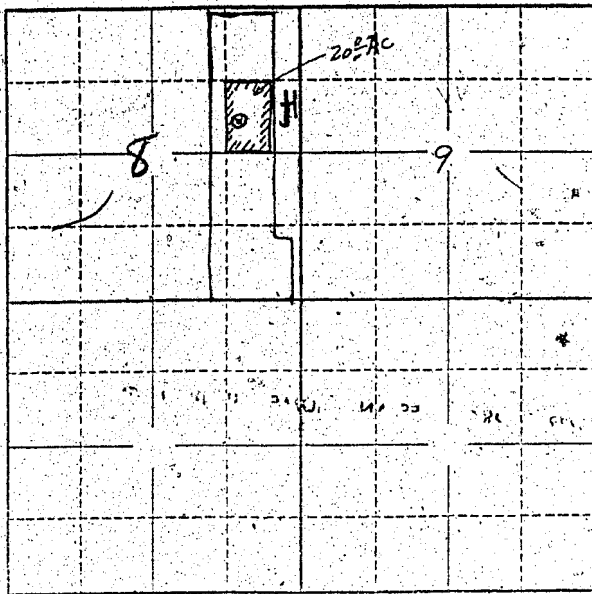

Locate well and acreage of irrigated land on plat.
Scale: 2" = 1 Mile

STATE OF OREGON }
County of Jackson } ss.

I, G. E. Custerhout, being first duly sworn, do hereby certify that I have read the foregoing Registration Statement and that all of the items therein contained are true to the best of my knowledge and belief.

G. E. Custerhout
(Signature of Registrant)

Subscribed and sworn to before me this 22nd day of July, 1958.

My commission expires Etta C. McFadyen
(Notary Public)

(SEAL)

MY COMMISSION EXPIRES MARCH 5th, 1960

CERTIFICATE OF REGISTRATION

STATE OF OREGON }
County of Marion } ss.

This is to certify that the foregoing Registration Statement was received in the office of the State Engineer on the 23 day of July, 1958 at 8:00 o'clock A. M. and has been duly recorded in said office in Book No: 16 of Registration Statements on page GR 3956

~~XX Construction shall be completed by 12 noon and the case do not apply to complete to~~
~~beneficial use by 12 noon XX~~

Witness my hand this 15th day of February, 1960.

Laura A. Stanley
(State Engineer)

\$15.00

By _____
(Deputy)

GR-3956