

# Registration Statement

## OF CLAIMANT OF RIGHT TO APPROPRIATE GROUND WATER

(Under Chapter 708, Oregon Laws 1955.)

TO THE STATE ENGINEER OF OREGON

I, JOSEPH A. HOLT

of Turner County of Marion

State of Oregon, do hereby make application for a certificate of registration as evidence of a right to appropriate ground water.

1. Source from which water is withdrawn is Flowing well  
(Flowing well, pump well, infiltration trench, or tunnel)

2. Location is: Approximately 2 and one-half miles Southeast of Turner, Oregon  
(Approximate distance and direction from nearest city or town)

and is more particularly described as follows: 210 feet east and 610 feet South from Center of Section 4.

(a) Located approximately 600 ft. due East of the N.E. Corner of the Issac Cook  
(Give distance and bearing to corner of section or other legal subdivision)

being within Donation Land Claim (see photo copy of Plat)  
(Smallest legal subdivision) of Sec. 4, Twp. 9 South, Rge. 2 West  
(N. or S.) (E. or W.)

(b) within limits of recorded platted property, town or city:

in Lot \_\_\_\_\_, Block \_\_\_\_\_ of \_\_\_\_\_  
(Name of plat or addition)

County of Marion  
(If within city or town, give name)

3. Construction Work was begun on April 1, 1953; was completed on April 23, 1953  
(Date) (Date)

and the ground water claimed was first used for the purposes set out below on April 23, 1953  
(Date)

since which time the water has been used continuously  
(Continuously or Intermittently)

from April 23, 1953 to \_\_\_\_\_ date \_\_\_\_\_  
(Date) (Date)

4. Quantity of water claimed and used is 100 gallons per minute; \_\_\_\_\_ acre feet per year.  
(Exempt)

5. Purpose or Purposes for which water is used domestic and irrigation  
(Domestic, irrigation, municipal, manufacturing, industrial, etc.)

6. Description of Well: Depth 51 feet feet. Type drilled  
(Dug or drilled)

diameter 8 inches. Elevation of ground at well site \_\_\_\_\_ feet, mean sea level.  
(As near as known)

Depth to water table \_\_\_\_\_ feet.

7. Capacity of Well: \_\_\_\_\_ g.p.m. with \_\_\_\_\_ feet drawdown.

\_\_\_\_\_ g.p.m. with \_\_\_\_\_ feet drawdown.

Date of test \_\_\_\_\_

If Flowing Well: Measured discharge 100 g.p.m. on \_\_\_\_\_  
(Date)

Shut-in pressure at ground surface \_\_\_\_\_ lbs. per sq. in. on \_\_\_\_\_  
(Date)


Water is controlled by NONE  
(Cap, valve, etc.)





Township 9 South Range 2 West, W.M.

North

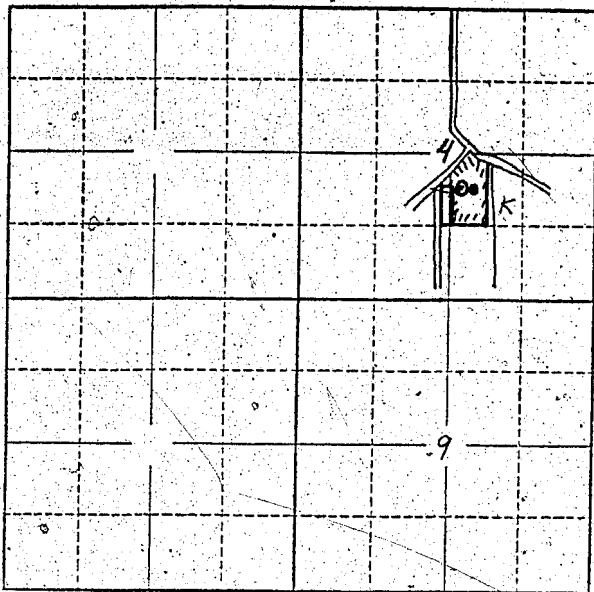

Locate well and acreage of irrigated land on plat.

Scale: 2" = 1 Mile

*See maps attached*

STATE OF OREGON

County of MARION

ss.

I, JOSEPH A. HOLT, being first duly sworn, do hereby certify that I have read the foregoing Registration Statement and that all of the items therein contained are true to the best of my knowledge and belief.

*Joseph A. Holt*  
(Signature of Registrant)

Subscribed and sworn to before me this 10th day of July 1950

My commission expires May 14th, 1962

*Will S. [Signature]*  
(Notary Public)

(SEAL)

CERTIFICATE OF REGISTRATION

STATE OF OREGON

County of Marion

ss.

This is to certify that the foregoing Registration Statement was received in the office of the State Engineer on the 23 day of July 1950, at 8:00 o'clock A.M. and has been duly recorded in said office in Book No. 16 of Registration Statements on page GR-3898

~~XX Construction shall be completed by 12 o'clock and the water completely applied to beneficial use by 10 o'clock XX~~

Witness my hand this 15th day of February 1960

*Laura A. Stanley*  
(State Engineer)

By

GR-3898

(Deputy)

\$15.00