

Registration Statement**OF CLAIMANT OF RIGHT TO APPROPRIATE GROUND WATER****TO THE STATE ENGINEER OF OREGON:**I, Agricultural Research Foundation, c/o Oregon State Collegeof Corvallis
(Mailing address)County of BentonState of Oregon, do hereby make application for a certificate of registration as evidence of a right to appropriate ground water.1. Source from which water is withdrawn is pump well
(Flowing well, pump well, infiltration trench, or tunnel)2. Location is: 1/2 mile S.E. of Gervais
(Approximate distance and direction from nearest city or town)

and is more particularly described as follows:

(a) From North Corner Peter Depot D.L.C. 54, S50¹/₂° E 2190', N41¹/₂° E 380'
(Give distance and bearing to corner of section or other legal subdivision)being within NW1/4 of SW1/4 of Sec. 25, Twp. 5S, Rge. 2W
(Smallest legal subdivision) (N. or S.) (E. or W.)

or (b) within limits of recorded platted property, town or city:

in Lot _____, Block _____ of _____
(If within city or town, give name)3. Construction Work was begun on Feb. 13, 1930; was completed on Feb. 27, 1930
(Date) (Date)and the ground water claimed was first used for the purposes set out below on April 1930
(Date)since which time the water has been used intermittently
(Continuously or intermittently)from April 1930 to present
(Date) (Date)4. Quantity of water claimed and used is 900 gallons per minute; 360 acre feet per year.

5. Purpose or Purposes for which water is used _____

irrigation and/or domestic
(Domestic, irrigation, municipal, manufacturing, industrial, etc.)6. Description of Well: Depth 255 feet. Type drilled
(Dug or drilled)diameter 18" - 155'; 6" - 155' to 255' inches. Elevation of ground at well site 179 feet, mean sea level.
(As near as known)Depth to water table 18 feet.7. Capacity of Well: 940 g.p.m. with 58 feet drawdown.620 g.p.m. with 40 feet drawdown.Date of test Mar. 11, 1930If Flowing Well: Measured discharge _____ g.p.m. on _____
(Date)Shut-in pressure at ground surface _____ lbs. per sq. in. on _____
(Date)Water is controlled by _____
(Cap, valve, etc.)

8. Casing: (Give diameter, commercial specifications and depth below ground surface of each casing size.)

18 inch diameter double 10 gauge "Calif. stove pipe" casing from 0 to 155 feet
 6 inch diameter steel casing from 150 to 255 feet
 inch diameter from to feet
 inch diameter from to feet

Describe and show depth of shoe, plug, adapter, liner or other details:

9. Perforated Casings or Screens:

Slits 1/2" x 2", 15 per ring, 6" ring spacing center to/ center from 117' to 147'
 (Number per foot and size of perforations, or describe screen)
 from 215' to 245'
 from to
 from to

10. Log of Well: (Describe each stratum or formation clearly, indicate if water bearing, and give thickness and depth as indicated.)

MATERIAL	Thickness (Feet)	Depth to Bottom (Feet)
clay	2	38
sand and clay	38	72
fine sand	72	85
sandy clay	85	108
fine black sand	108	112
sand and gravel	112	143
clay and gravel	143	146
sand	146	162
clay	162	180
sand	180	182
peat	182	183
clay and shale	183	205
sand and clay	205	218
sand and gravel	218	244
clay	244	252

A. M. Jannsen Drilling Company

11. Infiltration Trench: Covered or open

Dimensions: Length ft. Minimum depth ft. Maximum depth ft.

Bottom width ft. Discharge g.p.m. Date of test

12. Tunnel: Type of lining

Dimensions: _____
(Length, course, and cross sectional size)

Position of water bearing stratum with reference to portal of tunnel

Log of tunnel: (Preceding table for log of well may be used, if desired. Give footage from portal and character of materials, as pertinent.)

13. Pumping Equipment:

(a) Pump Sterling Unit type, 8" turbine, 2 stage, Capacity 900 g.p.m.
12" bowls, 8" suction, 6" discharge (type and size)


(b) Motor 20 HP U.S. motor, electric, 220 V, 1800 rpm
(Type and horsepower)

14. Location of area irrigated or to be irrigated, or place of use if for purposes other than irrigation.

[illegible]

15. If the ground water supply is supplemental to an existing water supply, identification of any application for a permit, permit, certificate or adjudicated right to appropriate water made or held by the registrant.

Township 55 Range 2 W, W.M.
North

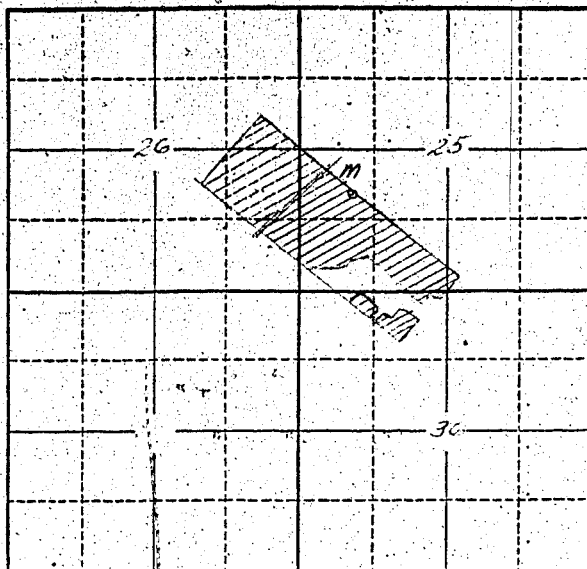

This well is owned by Oregon State College.

The irrigated acreage shown is privately owned but is presently being irrigated by the well.

Locate well and acreage of irrigated land on plat.

Scale: 2" = 1 Mile

STATE OF OREGON

County of Benton

} ss.

I, F.E. Price, being first duly sworn, do hereby certify that I have read the foregoing Registration Statement and that all of the items therein contained are true to the best of my knowledge and belief.

F.E. Price
(Signature of Registrant)
Vice-President, Agricultural Research Foundation

Subscribed and sworn to before me this 22 day of July, 19 58

My commission expires 4 Nov 1960

W.T. Linneman
(Notary Public)

(SEAL)

CERTIFICATE OF REGISTRATION

STATE OF OREGON

County of Marion

} ss.

This is to certify that the foregoing Registration Statement was received in the office of the State Engineer on the 23 day of July, 19 58, at 8:00 o'clock A. M. and has been duly recorded in said office in Book No. 10 of Registration Statements on page GR 2412

Witness my hand this 16th day of March, 19 59

\$27.80

By

(Deputy)

GR 2412