

Registration Statement

OF CLAIMANT OF RIGHT TO APPROPRIATE GROUND WATER

TO THE STATE ENGINEER OF OREGON:

I, William C Yeal
of Rt 1 Box 266 Hubbard County of Marion
(Mailing address)

State of _____, do hereby make application for a certificate of registration as evidence of a right to appropriate ground water.

1. Source from which water is withdrawn is PUMP Well
(Flowing well, pump well, infiltration trench, or tunnel)
2. Location is: one mile east of Hubbard
(Approximate distance and direction from nearest city or town)

and is more particularly described as follows:

(a) 1310 feet east & 450 feet south from NW corner of Section 3
(Give distance and bearing to corner of section or other legal subdivision)
being within NW 1/4 of NW 1/4 of Sec. 3, Twp. 5 S, Rge. 1 W
(Smallest legal subdivision) (N. or S.) (E. or W.)

or (b) within limits of recorded platted property, town or city: _____

in Lot _____, Block _____ of _____
(Name of plat or addition)
County of _____
(If within city or town, give name)

3. Construction Work was begun on April 14, 1954; was completed on April 1954
(Date) (Date)

and the ground water claimed was first used for the purposes set out below on July 23, 1958
(Date)

since which time the water has been used intermittently during season
(Continuously or intermittently)
from July April 1958 to Oct. 1958
(Date) (Date)

4. Quantity of water claimed and used is 140 gallons per minute; 30 acre feet per year.

5. Purpose or Purposes for which water is used irrigation
(Domestic, irrigation, municipal, manufacturing, industrial, etc.)

6. Description of Well: Depth 117 feet. Type drilled
(Dug or drilled)
diameter 8 inches. Elevation of ground at well site _____ feet, mean sea level.
(As near as known)
Depth to water table 141.91 feet.

7. Capacity of Well: 140 g.p.m. with 77 feet drawdown.
_____ g.p.m. with _____ feet drawdown.

Date of test April 14, 1954


If Flowing Well: Measured discharge _____ g.p.m. on _____
(Date)

Shut-in pressure at ground surface _____ lbs. per sq. in. on _____
(Date)

Water is controlled by _____
(Cap, valve, etc.)

Township 5S Range 1W, W.M.

North Rd

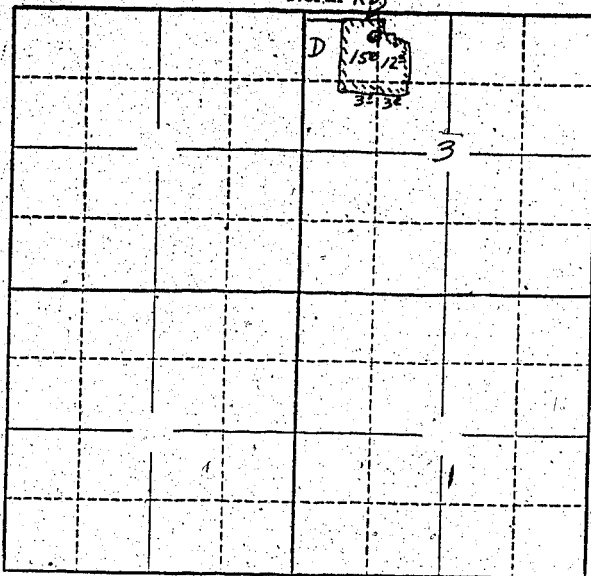

Locate well and acreage of irrigated land on plat.

Scale: 2" = 1 Mile

STATE OF OREGON

County of Marion } ss.

I, _____, being first duly sworn, do hereby certify that I have read the foregoing Registration Statement and that all of the items therein contained are true to the best of my knowledge and belief.

William C Deal
(Signature of Registrant)

Subscribed and sworn to before me this 23rd day of July, 1958

My commission expires 12th June 1961 Wm. S. Baitholmeis
(Notary Public)

(SEAL)

CERTIFICATE OF REGISTRATION

STATE OF OREGON

County of Marion } ss.

This is to certify that the foregoing Registration Statement was received in the office of the State Engineer on the 23rd day of July, 1958, at 12:30 o'clock A. M. and has been duly recorded in said office in Book No. 10 of Registration Statements on page GR-2413

Witness my hand this 16th day of March, 1959

Lawrence A. Stanley
(State Engineer)

By _____
(Deputy)

15.45

GR - 2413