

# Registration Statement

## OF CLAIMANT OF RIGHT TO APPROPRIATE GROUND WATER

TO THE STATE ENGINEER OF OREGON:

I, J. C. Mount

of 2295 Chemawa Road SALEM County of Marion  
(Mailing address)

State of Oregon, do hereby make application for a certificate of registration as evidence of a right to appropriate ground water.

1. Source from which water is withdrawn is Pump Well  
(Flowing well, pump well, infiltration trench, or tunnel)

2. Location is: 5 Miles north of Salem, Oregon  
(Approximate distance and direction from nearest city or town)

and is more particularly described as follows: 1270 feet east of 510 feet south from NW 1/4 corner Section 36.

(a) See separate map and legal description  
(Give distance and bearing to corner of section or other legal subdivision)

being within NW 1/4 of SW 1/4 of Sec. 36, Twp. 6 S, Rge. 3 W  
(Smallest legal subdivision) (N. or S.) (E. or W.)

or (b) within limits of recorded platted property, town or city:

in Lot \_\_\_\_\_, Block \_\_\_\_\_ of \_\_\_\_\_  
(Name of plat or addition)

County of Marion  
(If within city or town, give name)

3. Construction Work was begun on July 27, 1953; was completed on July 29, 1953  
(Date) (Date)

and the ground water claimed was first used for the purposes set out below on July 30, 1953  
(Date)

since which time the water has been used intermittantly during growing season  
(Continuously or Intermittently)

from July 30, 1953 to Present (July 8, 1958)  
(Date) (Date)

4. Quantity of water claimed and used is 120 gallons per minute; 4.41 acre feet per year.

5. Purpose or Purposes for which water is used Irrigation & Domestic

(Domestic, irrigation, municipal, manufacturing, industrial, etc.)

6. Description of Well: Depth 42.5 feet. Type Drilled  
(Dug or drilled)

diameter 8 inches. Elevation of ground at well site 40 feet, mean sea level.  
(As near as known)

Depth to water table 18 feet.

7. Capacity of Well: 370 g.p.m. with 5 feet drawdown.

130 g.p.m. with 2 feet drawdown.

Date of test July 30, 1953

If Flowing Well: Measured discharge \_\_\_\_\_ g.p.m. on \_\_\_\_\_  
(Date)

Shut-in pressure at ground surface \_\_\_\_\_ lbs. per sq. in. on \_\_\_\_\_  
(Date)


Water is controlled by \_\_\_\_\_  
(Cap, valve, etc.)





Township 6S Range 3W W.M.

North

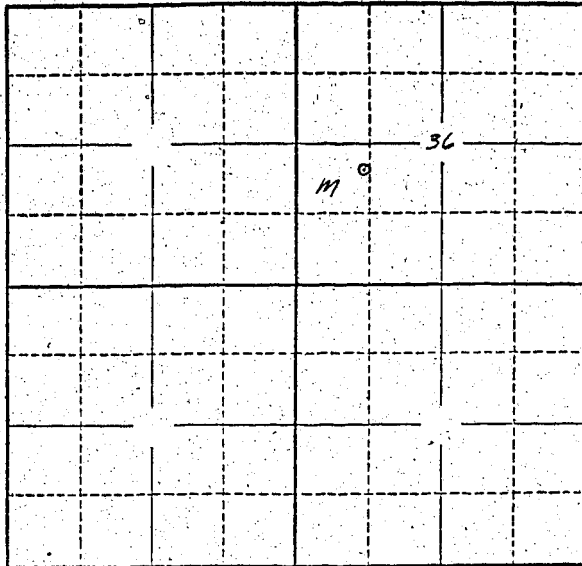

Locate well and acreage of irrigated land on plat.

Scale: 2" = 1 Mile

STATE OF OREGON

County of Marion } ss.

I, \_\_\_\_\_, being first duly sworn, do hereby certify that I have read the foregoing Registration Statement and that all of the items therein contained are true to the best of my knowledge and belief.

JL Mount  
(Signature of Registrant)

Subscribed and sworn to before me this 23rd day of July, 1958

My commission expires 12th June 1961 Wm. S. Bartholomew  
(Notary Public)

(SEAL)

**CERTIFICATE OF REGISTRATION**

STATE OF OREGON } ss.  
County of Marion

This is to certify that the foregoing Registration Statement was received in the office of the State Engineer on the 23rd day of July, 1958, at 1:30 o'clock P. M. and has been duly recorded in said office in Book No. 10 of Registration Statements on page GR 2415

Witness my hand this 16th day of March, 1959

Lewis A. Blum  
(State Engineer)

\$1500

By \_\_\_\_\_  
(Deputy)

GR 2415