

Registration Statement

OF CLAIMANT OF RIGHT TO APPROPRIATE GROUND WATER

TO THE STATE ENGINEER OF OREGON:

I, Chris Feigner & Carrie Feigner

of R.F.D. 2 Box 346 Milton, Freewater, Ore. County of Umatilla

(Mailing address)

State of Oregon, do hereby make application for a certificate of registration as evidence of a right to appropriate ground water.

1. Source from which water is withdrawn is Pump well #3

(Flowing well, pump well, infiltration trench, or tunnel)

2. Location is: 2 1/2 miles North west of Milton Freewater, Oregon

(Approximate distance and direction from nearest city or town)

and is more particularly described as follows:

(a) 050 ft. S. & 050 ft. E. of N.W. corner of the N.W. 1/4 of the S.W. 1/4 of Sec. 27 Twp. 6 N., Rge. 35 E.

(Give distance and bearing to corner of section or other legal subdivision)

being within N.W. 1/4 of S.W. 1/4 of S.E. 1/4 of Sec. 27, Twp. 6N., Rge. 35 E.

(Smallest legal subdivision)

(N. or S.)

(E. or W.)

or (b) within limits of recorded platted property, town or city:

in Lot _____, Block _____ of _____

(Name of plat or addition)

County of Umatilla

(If within city or town, give name)

3. Construction Work was begun on About 1910; was completed on About 1910

(Date)

(Date)

and the ground water claimed was first used for the purposes set out below on About 1910

(Date)

since which time the water has been used Continuously

(Continuously or intermittently)

from 1911 to 1957

(Date)

(Date)

4. Quantity of water claimed and used is 325 gallons per minute; _____ acre feet per year.

5. Purpose or Purposes for which water is used Irrigation

(Domestic, irrigation, municipal, manufacturing, industrial, etc.)

6. Description of Well: Depth 100 feet. Type Dug 45 ft., Drilled 55 ft.

(Dug or drilled)

diameter 60 inches. Elevation of ground at well site 950 feet, mean sea level.

(As near as known)

Depth to water table 30 feet.

7. Capacity of Well: 325 g.p.m. with 2 feet drawdown.

_____ g.p.m. with _____ feet drawdown.

Date of test July, 1957

If Flowing Well: Measured discharge _____ g.p.m. on _____

(Date)

Shut-in pressure at ground surface _____ lbs. per sq. in. on _____


(Date)

Water is controlled by _____

(Cap, valve, etc.)

Township 6 N. Range 35 E. W.M.

North

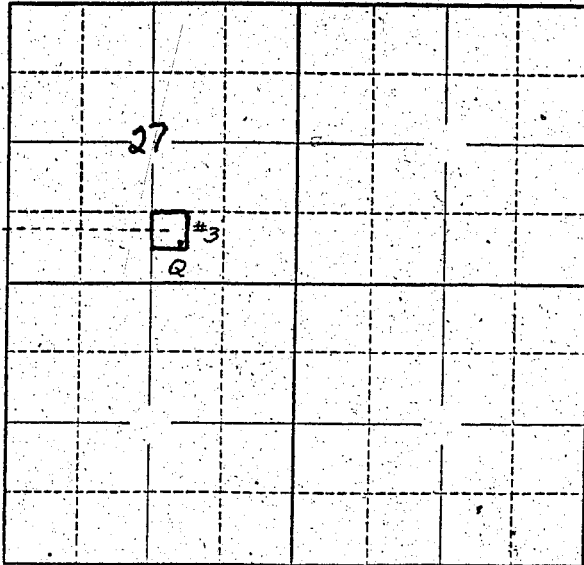

10 acres

Locate well and acreage of irrigated land on plat.

Scale: 2" = 1 Mile

STATE OF OREGON

County of Marion } ss.

I, W. A. [unclear], being first duly sworn, do hereby certify that I have read the foregoing Registration Statement and that all of the items therein contained are true to the best of my knowledge and belief.

(Signature of Registrant)

Subscribed and sworn to before me this 23rd day of July, 1958.

My commission expires 2-27-59 (Notary Public)

(SEAL)

CERTIFICATE OF REGISTRATION

STATE OF OREGON } ss.
County of Marion

This is to certify that the foregoing Registration Statement was received in the office of the State Engineer on the 23rd day of July, 1958, at 1.00 o'clock P. M. and has been duly recorded in said office in Book No. 10 of Registration Statements on page GR-2420

Witness my hand this 16th day of March, 1959.

(State Engineer)

By _____ (Deputy)

#15.00

GR - 2420