

Registration Statement

OF CLAIMANT OF RIGHT TO APPROPRIATE GROUND WATER

(Under Chapter 708, Oregon Laws 1955.)

TO THE STATE ENGINEER OF OREGON:

I, Peter A. Binford, 5554 N. E. Clackamas Street
of City of Portland County of Multnomah

State of Oregon, do hereby make application for a certificate of registration as evidence of a right to appropriate ground water.

1. Source from which water is withdrawn is Pump well
(Flowing well, pump well, infiltration trench, or tunnel)
2. Location is: Five miles southwest of Gresham, Oregon
(Approximate distance and direction from nearest city or town)

and is more particularly described as follows:

(a) 4000' East and 3000' No. of ^{SW} Corner of Sec. 17'
(Give distance and bearing to corner of section or other legal subdivision)
being within SW $\frac{1}{4}$ - NE $\frac{1}{4}$ of Sec. 17, Twp. 1 S., Rge. 3 E.
(Smallest legal subdivision) (N. or S.) (E. or W.)

or (b) within limits of recorded platted property, town or city:
in Lot _____, Block _____ of _____
(Name of plat or addition)
County of _____
(If within city or town, give name)

3. Construction Work was begun on April 1, 1953; was completed on July 2, 1953
(Date) (Date)
and the ground water claimed was first used for the purposes set out below on July 3, 1953
(Date)

since which time the water has been used continuously (by seasons)
(Continuously or intermittently)
from July 3, 1953 to July, 1958 (continuously)
(Date) (Date)

4. Quantity of water claimed and used is 260 gallons per minute; 267 acre feet per year.

5. Purpose or Purposes for which water is used Irrigation
(Domestic, irrigation, municipal, manufacturing, industrial, etc.)

6. Description of Well: Depth 200 approx feet. Type Drilled
(Dug or drilled)
diameter 8" inches. Elevation of ground at well site 500' approx feet, mean sea level.
(As near as known)
Depth to water table 20' feet.

7. Capacity of Well: unknown g.p.m. with _____ feet drawdown. Will stand continuous pumping at 260 gal. per minute
_____ g.p.m. with _____ feet drawdown.

Date of test _____


If Flowing Well: Measured discharge _____ g.p.m. on _____
(Date)

Shut-in pressure at ground surface _____ lbs. per sq. in. on _____
(Date)

Water is controlled by _____
(Cap, valve, etc.)

Map showing location of well and land irrigated is attached. Original is on file with State Engineer in connection with Reservoir Permit No. 24173.

Township 15 Range 3E W.M.
North

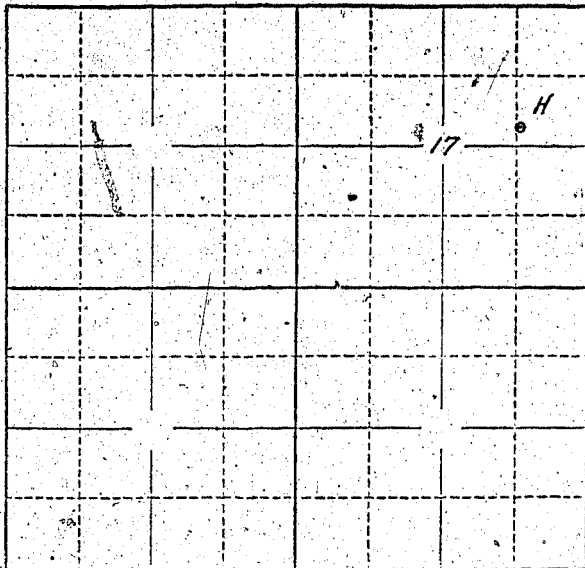

Locate well and acreage of irrigated land on plat.
Scale: 2" = 1 Mile

STATE OF OREGON

County of Multnomah } ss.

I, Peter A. Binford, being first duly sworn, do hereby certify that I have read the foregoing Registration Statement and that all of the items therein contained are true to the best of my knowledge and belief.

Peter A. Binford
(Signature of Registrant)

Subscribed and sworn to before me this 15th day of July, 1958.

My commission expires November 30, 1960.

W. B. Bradford
(Notary Public)

(SEAL)

CERTIFICATE OF REGISTRATION

STATE OF OREGON } ss.
County of Marion

This is to certify that the foregoing Registration Statement was received in the office of the State Engineer on the 23 day of July, 1958, at 5:00 o'clock A. M. and has been duly recorded in said office in Book No. 110 of Registration Statements on page GR-2422.

~~Construction shall be completed by _____ and the cost thereof shall be _____~~
~~_____~~

Witness my hand this 16th day of March, 1959.

Lewis A. Pittman
(State Engineer)

\$ 23.85

By _____ (Deputy)
GR-2422