

Registration Statement

OF CLAIMANT OF RIGHT TO APPROPRIATE GROUND WATER

TO THE STATE ENGINEER OF OREGON:

I, Ralph P. Sticks
 of P.O. Box 425 - Canby County of Clackamas
(Mailing address)
 State of Oregon, do hereby make application for a certificate of registration as evidence of a right to appropriate ground water.

1. Source from which water is withdrawn is Pump Well
(Flowing well, pump well, infiltration trench, or tunnel)
2. Location is: 1 mi North of Canby
(Approximate distance and direction from nearest city or town)

and is more particularly described as follows: 1850 feet South & 200 feet East from the N¹/₄ corner

(a) Quinaland lots 36637
(Give distance and bearing to corner of section or other legal subdivision)
 being within SW¹/₄ of NE¹/₄ of Sec. 28, Twp. 3S, Rge. 1E
(Smallest legal subdivision) (N. or S.) (E. or W.)

or (b) within limits of recorded platted property, town or city: Canby
 in Lot _____ Block _____ of Plat 76
(Name of plat or addition)
 County of Clackamas
(If within city or town, give name)

3. Construction Work was begun on 2-4-1942; was completed on 8-23-41
(Date) (Date)

and the ground water claimed was first used for the purposes set out below on 1942
(Date)

since which time the water has been used Continuously
(Continuously or intermittently)

from 1942 to Present Time
(Date) (Date)

4. Quantity of water claimed and used is 80 gallons per minute; _____ acre feet per year.

5. Purpose or Purposes for which water is used Water for Irrigation

(Domestic, irrigation, municipal, manufacturing, industrial, etc.)

6. Description of Well: Depth 80 feet. Type Drilled
(Dug or drilled)

diameter 6 inches. Elevation of ground at well site 124 feet, mean sea level.
(As near as known)

Depth to water table 48 feet.

7. Capacity of Well: 90 g.p.m. with 20 feet drawdown.
 _____ g.p.m. with _____ feet drawdown.


Date of test Aug 1942

If Flowing Well: Measured discharge _____ g.p.m. on _____
(Date)

Shut-in pressure at ground surface _____ lbs. per sq. in. on _____
(Date)

Water is controlled by _____
(Cap, valve, etc.)

Township 3S Range 1E, W.M.
North

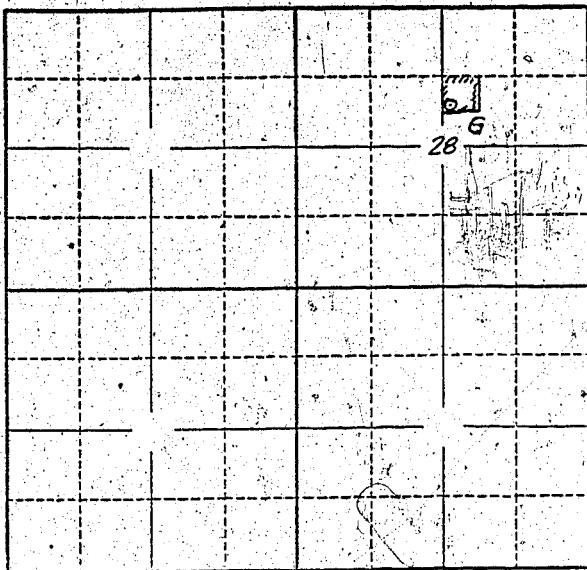

Locate well and acreage of irrigated land on plat.
Scale: 2" = 1 Mile

STATE OF OREGON

County of Marion } ss.

I, Ralph P. Sucka, being first duly sworn, do hereby certify that I have read the foregoing Registration Statement and that all of the items therein contained are true to the best of my knowledge and belief.

Ralph P. Sucka
(Signature of Registrant)

Subscribed and sworn to before me this 23rd day of July, 1958

My commission expires 12th June 1961

Wm. S. Bartholomew
(Notary Public)

(SEAL)

CERTIFICATE OF REGISTRATION

STATE OF OREGON

County of Marion } ss.

This is to certify that the foregoing Registration Statement was received in the office of the State Engineer on the 23rd day of July, 1958, at 7:30 o'clock P. M. and has been duly recorded in said office in Book No. 11 of Registration Statements on page GR-2424

Witness my hand this 16th day of March, 1959

Leura A. Stanton
(State Engineer)

By _____

(Deputy)

GR-2424

\$ 15.00