

Registration Statement

OF CLAIMANT OF RIGHT TO APPROPRIATE GROUND WATER

TO THE STATE ENGINEER OF OREGON:

I, H. W. Russell
of Box 137 D, Aumsville County of Marion
(Mailing address)

State of Oregon, do hereby make application for a certificate of registration as evidence of a right to appropriate ground water.

1. Source from which water is withdrawn is large diameter pump well
(Flowing well, pump well, infiltration trench, or tunnel)

2. Location is: 1/2 mi. west & 1/2 mi. south of West Clayton
(Approximate distance and direction from nearest city or town)

and is more particularly described as follows:
930' N of the S.W. corner of property which is a point on the W. line of the
From Geo. Neal D.L.C. N.W. Corner

(a) George Neal D.L.C. being S. 154° 45' E. 50 chains more or less along D.L.C. West line.
(Give distance and bearing to corner of section or other legal subdivision)

being within NE 1/4 NW 1/4 of Sec. 24, Twp. 9 S, Rge. 2 W
(Smallest legal subdivision) (N. or S.) (E. or W.)

or (b) within limits of recorded platted property, town or city:

in Lot _____, Block _____ of _____
(Name of plat or addition)

County of Marion
(If within city or town, give name)

3. Construction Work was begun on Dec. 1950; was completed on April 1958
(Date) (Date)

and the ground water claimed was first used for the purposes set out below on 1951
(Date)

since which time the water has been used intermittently each irrigation season
(Continuously or intermittently)

from May 1 to Sept 1
(Date) (Date)

4. Quantity of water claimed and used is 120 gallons per minute; 60 acre feet per year.

5. Purpose or Purposes for which water is used irrigation

(Domestic, irrigation, municipal, manufacturing, industrial, etc.)

6. Description of Well: Depth 8 feet. Type Dug
(Dug or drilled)

diameter 40' x 200' inches. Elevation of ground at well site _____ feet, mean sea level.
(AS near as known)

Depth to water table 2 feet.

7. Capacity of Well: _____ g.p.m. with _____ feet drawdown.

_____ g.p.m. with _____ feet drawdown.

Date of test Never tested


If Flowing Well: Measured discharge _____ g.p.m. on _____
(Date)

Shut-in pressure at ground surface _____ lbs. per sq. in. on _____
(Date)

Water is controlled by _____
(Cap, valve, etc.)

Township 7 S. Range 2 W., W.M.

North

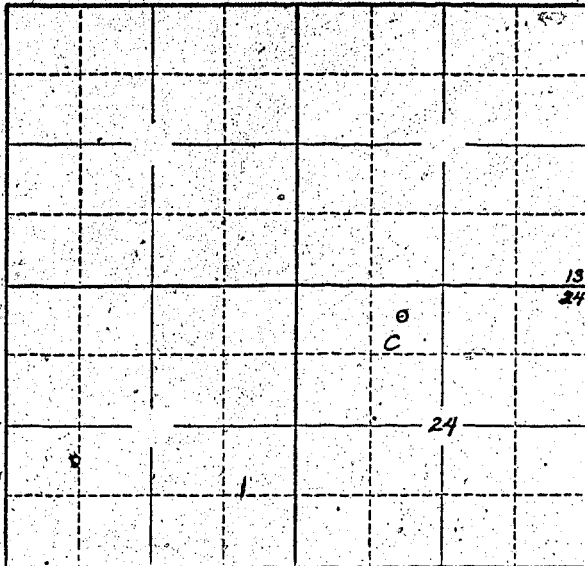

Locate well and acreage of irrigated land on plat.

Scale: 2" = 1 Mile

STATE OF OREGON

County of Marion

} ss.

I, H. W. Russell, being first duly sworn, do hereby certify that I have read the foregoing Registration Statement and that all of the items therein contained are true to the best of my knowledge and belief.

H. W. Russell
(Signature of Registrant)

Subscribed and sworn to before me this 23 day of July, 1958

My commission expires 12th June 1961

Wm. S. Bartholmeus
(Notary Public)

(SEAL)

CERTIFICATE OF REGISTRATION

STATE OF OREGON

County of Marion

} ss.

This is to certify that the foregoing Registration Statement was received in the office of the State Engineer on the 23rd day of July, 1958, at 3:15 o'clock P. M. and has been duly recorded in said office in Book No. 11 of Registration Statements on page GR 2428.

Witness my hand this 16th day of March, 1959

Lewis A. Stanley
(State Engineer)

By

(Deputy)

GR - 2428

#15.30