

Registration Statement

OF CLAIMANT OF RIGHT TO APPROPRIATE GROUND WATER

TO THE STATE ENGINEER OF OREGON:

I, Robert A. Magee

of Route 1, Box 147, Dayton County of Yamhill
(Mailing address)

State of Oregon, do hereby make application for a certificate of registration as evidence of a right to appropriate ground water.

1. Source from which water is withdrawn is a pump well
(Flowing well, pump well, infiltration trench, or tunnel)

2. Location is: seven miles south of Dayton
(Approximate distance and direction from nearest city or town)

and is more particularly described as follows: (well #2 on attached map)

(a) 1228' S., 235' W. of N. 1/4 corner Section 21
(Give distance and bearing to corner of section or other legal subdivision)

being within SE 1/4 of NE 1/4, NW 1/4 of Sec. 21, Twp. 5 S., Rge. 3 W.
(Smallest legal subdivision) (N. or S.) (E. or W.)

or (b) within limits of recorded platted property, town or city:

in Lot _____, Block _____ of _____
(Name of plat or addition)

County of Yamhill
(If within city or town, give name)

3. Construction Work was begun on Jan. 1, 1950; was completed on Apr. 1, 1950
(Date) (Date)

and the ground water claimed was first used for the purposes set out below on May 1, 1950
(Date)

since which time the water has been used intermittently for irrigation
(Continuously or intermittently)

from May 1, 1950 to 1958 (present)
(Date) (Date)

4. Quantity of water claimed and used is 170 gallons per minute; 50 acre feet per year.

5. Purpose or Purposes for which water is used is supplemental irrigation,
connected with old registered well (well # 1 on map) GR-119
(Domestic, irrigation, municipal, manufacturing, industrial, etc.)

6. Description of Well: Depth 130 feet. Type Drilled
(Dug or drilled)

diameter 8 inches. Elevation of ground at well site _____ feet, mean sea level.
(As near as known)

Depth to water table 39 feet.

7. Capacity of Well: 170 g.p.m. with 85 feet drawdown.

200 g.p.m. with 100 feet drawdown.


Date of test _____

If Flowing Well: Measured discharge _____ g.p.m. on _____
(Date)

Shut-in pressure at ground surface _____ lbs. per sq. in. on _____
(Date)

Water is controlled by _____
(Cap, valve, etc.)

Township 55 Range 34 W.M.
North

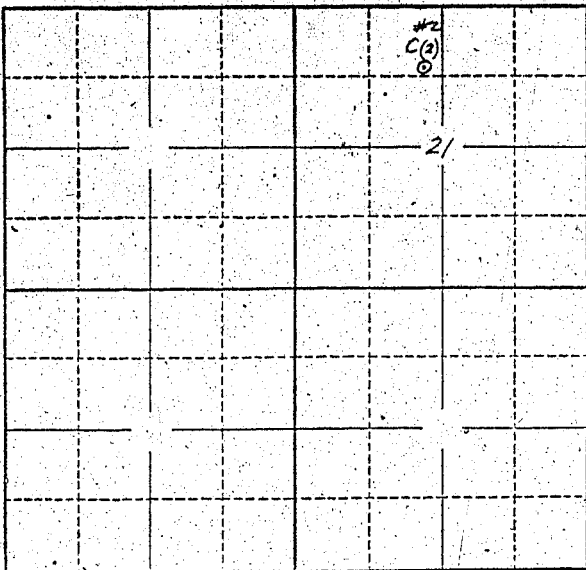

Locate well and acreage of irrigated land on plat.
Scale: 2" = 1 Mile

STATE OF OREGON }
County of Marion } ss.

I, Robert A. Magee, being first duly sworn, do hereby certify that I have read the foregoing Registration Statement and that all of the items therein contained are true to the best of my knowledge and belief.

Robert A. Magee
(Signature of Registrant)

Subscribed and sworn to before me this 23rd day of July, 1958

My commission expires 12th June 1961 Wm. S. Bartholomew
(Notary Public)

(SEAL)

CERTIFICATE OF REGISTRATION

STATE OF OREGON }
County of Marion } ss.

This is to certify that the foregoing Registration Statement was received in the office of the State Engineer on the 23rd day of July, 1958, at 3:12 o'clock P. M. and has been duly recorded in said office in Book No. 11 of Registration Statements on page GR-2430

Witness my hand this 16th day of March, 1959

James A. Sturley
(State Engineer)

By _____ (Deputy)

GR - 2430

24/22