

22-35

GR-2579  
GR-2449

# Registration Statement

## OF CLAIMANT OF RIGHT TO APPROPRIATE GROUND WATER

(Under Chapter 708, Oregon Laws 1955.)

TO THE STATE ENGINEER OF OREGON:

I, Paul Jensen  
Box 195 Silverton  
of Bl. 2, Hamletburg County of Lincoln Marion

State of Oregon, do hereby make application for a certificate of registration as evidence of a right to appropriate ground water.

- 1. Source from which water is withdrawn is pump well #1  
(Flowing well, pump well, infiltration trench, or tunnel)
- 2. Location is: 5 miles west of Silverton, Oregon  
(Approximate distance and direction from nearest city or town)

and is more particularly described as follows:

(a) 5 81°30'E. 424.57 227.657  
(Give distance and bearing to corner of section or other legal subdivision)  
To S.E. Cor. of Sec. 35

being within S.E. 4 S.E. 1/4 of Sec. 35, Twp. 6S. Rge. R. 2W.  
(Smallest legal subdivision) (of or S.) (of or W.)

or (b) within limits of recorded platted property, town or city:

in Lot \_\_\_\_\_, Block \_\_\_\_\_ of \_\_\_\_\_  
(Name of plat or addition)

County of Marion  
(If within city or town, give name)

3. Construction Work was begun on Sept 1952; was completed on Oct 10 1952  
(Date) (Date)

and the ground water claimed was first used for the purposes set out below on May 1955  
(Date)

since which time the water has been used \_\_\_\_\_  
(Continuously or intermittently)

from May 1955 to Sept 1957  
(Date) (Date)

4. Quantity of water claimed and used is 476 gallons per minute; \_\_\_\_\_ acre feet per year.

5. Purpose or Purposes for which water is used Irrigation

(Domestic, irrigation, municipal, manufacturing, industrial, etc.)

6. Description of Well: Depth 49.55 feet. Type Billed  
(Dug or drilled)

diameter 10 inches. Elevation of ground at well site 200 feet, mean sea level.  
(As near as known)

Depth to water table 4.5 feet. in 1952

7. Capacity of Well: 500 g.p.m. with \_\_\_\_\_ feet drawdown. at 145'  
\_\_\_\_\_ g.p.m. with \_\_\_\_\_ feet drawdown. at 120'

Date of test Oct 2 1952

If Flowing Well: Measured discharge \_\_\_\_\_ g.p.m. on \_\_\_\_\_  
(Date)

Shut-in pressure at ground surface \_\_\_\_\_ lbs. per sq. in. on \_\_\_\_\_  
(Date)

Water is controlled by \_\_\_\_\_  
(Cap, valve, etc.)

8. Casing: (Give diameter, commercial specifications and depth below ground surface of each casing size.)

10 inch diameter 7/8 Black Standard pipe from 0 to 155 feet  
 inch diameter ..... from ..... to ..... feet  
 inch diameter ..... from ..... to ..... feet  
 inch diameter ..... from ..... to ..... feet

Describe and show depth of shoe, plug, adapter, liner or other details:  
1 Steel drive shoe on bottom

9. Perforated Casings or Screens:

4 to 5 every 2 ft 3/8 by 3" from 90 ft to 154  
(Number per foot and size of perforations, or describe screen)  
 from ..... to .....  
 from ..... to .....  
 from ..... to .....

10. Log of Well: (Describe each stratum or formation clearly, indicate if water bearing, and give thickness and depth as indicated.)

MATERIAL	Thickness (Feet)	Depth to Bottom (Feet)
Top Soil Brown	4	4
Loam - Brown	26	30
Clay - Blue	20	50
Sandy Clay Blue	25	75
Sandy Clay Brown	5	80
Sand Redish brown	5	85
Cement Gravel & water bearing sand and gravel grey	65	155

If log of well is not available, give name and address of driller. Stadile

X 11. Infiltration Trench: Covered or open .....

Dimensions: Length ..... ft. Minimum depth ..... ft. Maximum depth ..... ft.  
 Bottom width ..... ft. Discharge ..... g.p.m. Date of test .....

X 12. Tunnel: Type of lining .....

Dimensions: .....  
(Length, course, and cross sectional size)  
 Position of water bearing stratum with reference to portal of tunnel .....

Log of tunnel: (Preceding table for log of well may be used, if desired. Give footage from portal and character of materials, as pertinent.)

✓ 13. Pumping Equipment:

(a) Pump Jacuzzi Turbine Capacity 476 g.p.m.  
(Make, type and size)  
 (b) Motor 30 H.P. Electric 3 phase  
(Type and horsepower)


14. Location of area irrigated or to be irrigated, or place of use if for purposes other than irrigation.

Township North or South	Range E. or W. of Willamette Meridian	Section	Forty-acre Tract	Number Acres To Be Irrigated	Date of Reclamation
G5	2W	36	S.W. 1/4 S.W. 1/4	3.3	1955
"	"	35	N.E. 1/4 S.E. 1/4	4.1	"
"	"	"	N.W. 1/4 S.E. 1/4	0.6	"
"	"	"	S.W. 1/4 S.E. 1/4	6.5	"
"	"	"	S.E. 1/4 S.E. 1/4	39.6	"
75	2W	2	N.W. 1/4 N.E. 1/4	4.3	"
"	"	"	N.E. 1/4 N.E. 1/4	20.3	"
				<u>78.7 Total Ac.</u>	"
J					

15. If the ground water supply is supplemental to an existing water supply, identification of any application for a permit, permit, certificate or adjudicated right to appropriate water made or held by the registrant.

None

Township 65 Range 24 W.M.  
North

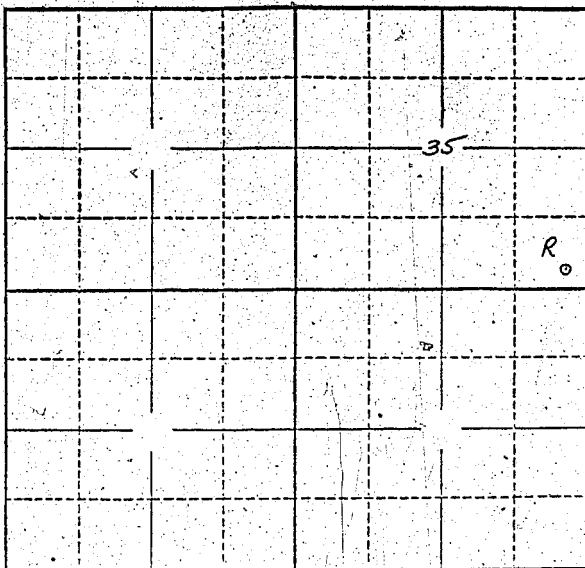

Locate well and acreage of irrigated land on plat.  
Scale: 2" = 1 Mile.

STATE OF OREGON

County of Marion ss.

I, Paul Jensen being first duly sworn, do hereby certify that I have read the foregoing Registration Statement and that all of the items therein contained are true to the best of my knowledge and belief.

Paul Jensen  
(Signature of Registrant)

Subscribed and sworn to before me this 24th day of July, 1958

My commission expires 12th June 1961

Wm. S. Bartholomew  
(Notary Public)

(SEAL)

**CERTIFICATE OF REGISTRATION**

STATE OF OREGON

County of Marion } ss.

This is to certify that the foregoing Registration Statement was received in the office of the State Engineer on the 24th day of July, 1958, at 4:00 o'clock P. M. and has been duly recorded in said office in Book No. 11 of Registration Statements on page GR 2449

~~Construction shall be completed by \_\_\_\_\_ and the water conveyed to the beneficial use by \_\_\_\_\_~~

Witness my hand this 16th day of March, 1959

Arthur A. Stinson  
(State Engineer)

#22-35

By \_\_\_\_\_ (Deputy)

GR-2449