

Registration Statement

OF CLAIMANT OF RIGHT TO APPROPRIATE GROUND WATER

TO THE STATE ENGINEER OF OREGON:

I, H. C. Costanzo of Albion Farm
 of 1457 1/2 Shattuck St. Portland County of Multnomah
(Mailing Address)
 State of Oregon, do hereby make application for a certificate of registration as evidence of a right to appropriate ground water.

1. Source from which water is withdrawn is sump well
(Flowing well, pump well, infiltration trench, or tunnel)
2. Location is: 6 miles southeast of Portland
(Approximate distance and direction from nearest city or town)

and is more particularly described as follows:

(a) 1455.63' S 28°30' W to 13/18 24/19
(Give distance and bearing to corner of section or other legal subdivision)
 being within S.W. 1/4 of SW 1/4 of Sec. 18, Twp. 1 S, Rge. 1 E
(Smallest legal subdivision) (N. or S.) (E. or W.)
 or (b) within limits of recorded platted property, town or city:

in Lot _____, Block _____ of _____
(Name of plat or addition)
 County of Multnomah
(If within city or town, give name)

3. Construction Work was begun on possibly before 1927; was completed on 1927
(Date) (Date)

and the ground water claimed was first used for the purposes set out below on 1943
(Date)
 since which time the water has been used continuously since 1943 for Albion Farm
(Continuously or Intermittently)
 from 1927 to 1958
(Date) (Date)

4. Quantity of water claimed and used is 140 gallons per minute; _____ acre feet per year.

5. Purpose or Purposes for which water is used operating milk plant, irrigation, ~~and for~~
~~for purposes, highways etc.~~
(Domestic, irrigation, municipal, manufacturing, industrial, etc.)

6. Description of Well: Depth 420 feet. Type drilled
(Dug or drilled)
 diameter 8 inches. Elevation of ground at well site 30 ft feet, mean sea level.
(As near as known)
 Depth to water table _____ feet.

7. Capacity of Well: 140 g.p.m. with 6.3 feet drawdown.
 _____ g.p.m. with _____ feet drawdown.

Date of test 3/1958


If Flowing Well: Measured discharge _____ g.p.m. on _____ (Date)

Shut-in pressure at ground surface _____ lbs. per sq. in. on _____ (Date)

Water is controlled by _____ (Cap, valve, etc.)

H. C. Costanzo
 FOR MEASUREMENTS ON WELL LOG

Township 15 Range 1E, W.M.
North

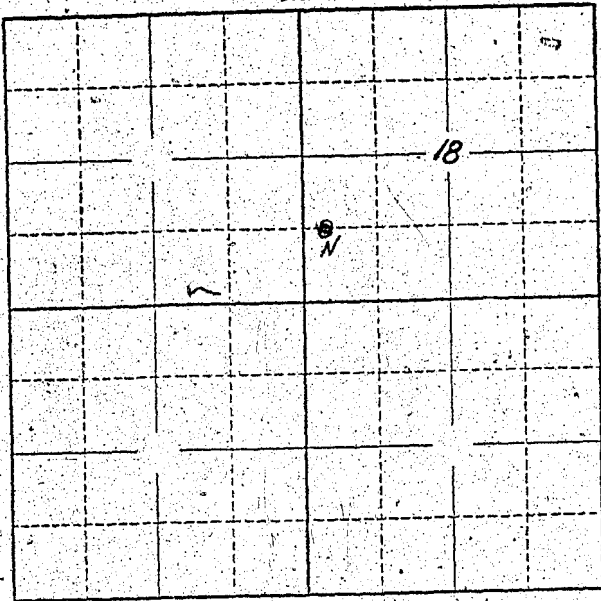

Locate well and acreage of irrigated land on plat.
Scale: 2" = 1 Mile

STATE OF OREGON

County of Multnomah } ss.

I, H.C. Cadore, being first duly sworn, do hereby certify that I have read the foregoing Registration Statement and that all of the items therein contained are true to the best of my knowledge and belief.

H.C. Cadore
(Signature of Registrant)

Subscribed and sworn to before me this 24 day of July, 1958

My commission expires Jan 3 1961

James Leahy
(Notary Public)

(SEAL)

CERTIFICATE OF REGISTRATION

STATE OF OREGON } ss.
County of Marion

This is to certify that the foregoing Registration Statement was received in the office of the State Engineer on the 24 day of July, 1958, at 8:00 o'clock A.M. and has been duly recorded in said office in Book No. 16 of Registration Statements on page GR 3994

Witness my hand this 15th day of February, 1960

Barrie A. Stanley
(State Engineer)

By _____ (Deputy)

28.30