

Registration No. GR - 2586

Certificate No. GR 2453

Registration Statement

OF CLAIMANT OF RIGHT TO APPROPRIATE GROUND WATER

TO THE STATE ENGINEER OF OREGON:

I, Eva M. Knox
of Route 2, Eugene County of Lane
(Mailing address)

State of Oregon, do hereby make application for a certificate of registration as evidence of a right to appropriate ground water.

1. Source from which water is withdrawn is pump well
(Flowing well, pump well, infiltration trench, or tunnel)

2. Location is: 1 mile west of Coburg
(Approximate distance and direction from nearest city or town)

and is more particularly described as follows:

(a) 1100' East and 1400' North of the 1/2 sec. cor. common to sec. 31 & 32
(Give distance and bearing to corner of section or other legal subdivision)
being within MP 1 NW 1 of Sec. 32, Twp. 16 S., Rge. 3 W.
(Smallest legal subdivision) (N. or S.) (E. or W.)

or (b) within limits of recorded platted property, town or city:

in Lot _____ Block _____ of _____
(Name of plat or addition)
County of Lane
(If within city or town, give name)

3. Construction Work was begun on May, 1948; was completed on May, 1948
(Date) (Date)

and the ground water claimed was first used for the purposes set out below on May, 1948
(Date)

since which time the water has been used intermittently
(Continuously or intermittently)
from May to October
(Date) (Date)

4. Quantity of water claimed and used is 300 gallons per minute; 20 acre feet per year.

5. Purpose or Purposes for which water is used Irrigation
(Domestic, irrigation, municipal, manufacturing, industrial, etc.)

6. Description of Well: Depth 20 feet. Type Driven
(Dug or drilled)
diameter 3-3 inches. Elevation of ground at well site 380 feet, mean sea level.
(As near as known)
Depth to water table 14 feet.

7. Capacity of Well: 300 g.p.m. with 1 feet drawdown.
_____ g.p.m. with _____ feet drawdown.


Date of test no actual test

If Flowing Well: Measured discharge _____ g.p.m. on _____
(Date)

Shut-in pressure at ground surface _____ lbs. per sq. in. on _____
(Date)

Water is controlled by _____
(Cap, valve, etc.)

Township 16 S Range 3 W, W.M.
North

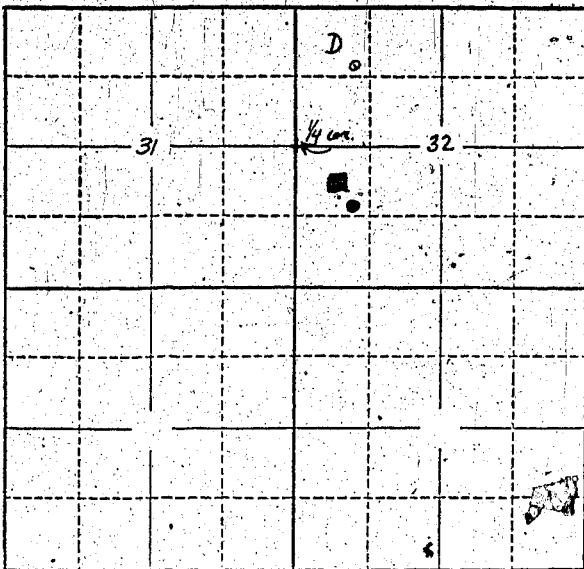

Locate well and acreage of irrigated land on plat.
Scale: 2" = 1 Mile

STATE OF OREGON

County of Lane } ss.

I, _____, being first duly sworn, do hereby certify that I have read the foregoing Registration Statement and that all of the items therein contained are true to the best of my knowledge and belief.

Eva M Knox Thomason
(Signature of Registrant)

Subscribed and sworn to before me this 19th day of Sept, 1959

My commission expires Jan 23, 1961

Walter L. Linn
(Notary Public)
State of Oregon Lane County

(SEAL)

CERTIFICATE OF REGISTRATION

STATE OF OREGON

County of Marion } ss.

This is to certify that the foregoing Registration Statement was received in the office of the State Engineer on the 24th day of July, 1958, at 8:00 o'clock A. M. and has been duly recorded in said office in Book No. 11 of Registration Statements on page GR-2453

Witness my hand this 16th day of March, 1959

Laura A. Stanley
(State Engineer)

By _____ (Deputy)

GR - 2453

#1500