

# Registration Statement

## OF CLAIMANT OF RIGHT TO APPROPRIATE GROUND WATER

TO THE STATE ENGINEER OF OREGON:

I, Roy J. & Sidney E. Mosner  
of 3080 SW River Road Hillsboro County of Washington  
State of Oregon do hereby make application for a certificate of registration as evidence  
of a right to appropriate ground water.

- 1. Source from which water is withdrawn is Pump well  
(Flowing well, pump well, infiltration trench, or tunnel)
- 2. Location is: 3 miles ESE of Hillsboro  
(Approximate distance and direction from nearest city or town)

and is more particularly described as follows:

(a) 280' E of N from 1/4 corner on West Line of Sec. 9  
(Give distance and bearing to corner of section or other legal subdivision)  
being within SW 1/4 of NW 1/4 of Sec. 9, Twp. 15, Rge. 2W  
(Smallest legal subdivision) (or S.) (or W.)

or (b) within limits of recorded platted property, town or city:  
in Lot \_\_\_\_\_, Block \_\_\_\_\_ of \_\_\_\_\_  
(Name of plat or addition)

County of \_\_\_\_\_  
(If within city or town, give name)

3. Construction Work was begun on 5-2-53; was completed on 5-7-53  
(Date) (Date)  
and the ground water claimed was first used for the purposes set out below on July - 53  
(Date)  
since which time the water has been used intermittently  
(Continuously or Intermittently)  
from 1953 to Present  
(Date) (Date)

4. Quantity of water claimed and used is 21 gallons per minute; 10 acre feet per year.

5. Purpose or Purposes for which water is used irrigate pasture  
(Domestic, irrigation, municipal, manufacturing, industrial, etc.)

6. Description of Well: Depth 55 feet. Type Drilled  
(Dug or drilled)  
diameter 6 inches. Elevation of ground at well site 166 feet, mean sea level.  
(As near as known)  
Depth to water table 21 feet.

7. Capacity of Well: 42 g.p.m. with 9 feet drawdown.  
\_\_\_\_\_ g.p.m. with \_\_\_\_\_ feet drawdown:

Date of test 5-7-53

If Flowing Well: Measured discharge \_\_\_\_\_ g.p.m. on \_\_\_\_\_  
(Date)

Shut-in pressure at ground surface \_\_\_\_\_ lbs. per sq. in. on \_\_\_\_\_  
(Date)


Water is controlled by \_\_\_\_\_  
(Cap, valve, etc.)





Township 1S Range 2W, W.M.

North

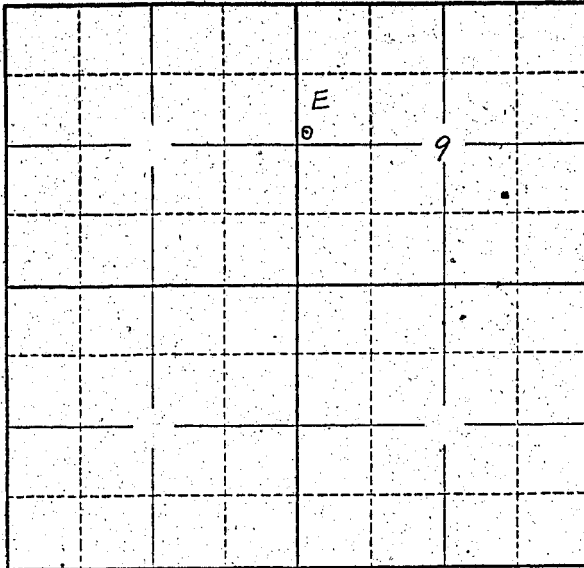

Locate well and acreage of irrigated land on plat.

Scale: 2" = 1 Mile

STATE OF OREGON

County of Washington } ss.

I, Kay J. McInnes, being first duly sworn, do hereby certify that I have read the foregoing Registration Statement and that all of the items therein contained are true to the best of my knowledge and belief.

Kay J. McInnes  
(Signature of Registrant)

Subscribed and sworn to before me this 23 day of July, 1958

My commission expires May 10, 1959  
(Notary Public)

NOTARY PUBLIC FOR OREGON  
My Commission Expires May 10, 1959

(SEAL)

**CERTIFICATE OF REGISTRATION**

STATE OF OREGON } ss.  
County of Marion

This is to certify that the foregoing Registration Statement was received in the office of the State Engineer on the 24th day of July, 1958, at 8:00 o'clock A.M. and has been duly recorded in said office in Book No. 11 of Registration Statements on page GR-2459

Witness my hand this 6th day of April, 1959

Lewis A. Stanley  
(State Engineer)

By \_\_\_\_\_ (Deputy)

\$15.00

GR - 2459