

Registration Statement

OF CLAIMANT OF RIGHT TO APPROPRIATE GROUND WATER

TO THE STATE ENGINEER OF OREGON:

I, Chris Scheffel

of Halsey County of Linn
(Mailing address)

State of Oregon, do hereby make application for a certificate of registration as evidence of a right to appropriate ground water.

1. Source from which water is withdrawn is pump well
(Flowing well, pump well, infiltration trench, or tunnel)

2. Location is: 7 miles north of Harrisburg, Oregon
(Approximate distance and direction from nearest city or town)

and is more particularly described as follows:

(a) 2640 feet south and 850 feet west of N. E. corner
(Give distance and bearing to corner of section or other legal subdivision)
being within S. E. 1/4 of N. E. 1/4 of Sec. 21, Twp. 148, Rge. 4 W
(Smallest legal subdivision) (N. or S.) (E. or W.)

or (b) within limits of recorded platted property, town or city:

in Lot _____, Block _____ of _____
(Name of plat or addition)
County of _____
(If within city or town, give name)

3. Construction Work was begun on July 1951; was completed on July 1951
(Date) (Date)

and the ground water claimed was first used for the purposes set out below on July 1951
(Date)

since which time the water has been used intermittently
(Continuously or intermittently)

from May to October each year.
(Date) (Date)

4. Quantity of water claimed and used is 500 gallons per minute; 105 acre feet per year.

5. Purpose or Purposes for which water is used irrigation
(Domestic, irrigation, municipal, manufacturing, industrial, etc.)

6. Description of Well: Depth 109 feet. Type drilled
(Dug or drilled)
diameter 10 inches. Elevation of ground at well site 270 feet, mean sea level.
(As near as known)
Depth to water table 16 feet.

7. Capacity of Well: 750 g.p.m. with 45 feet drawdown.
_____ g.p.m. with _____ feet drawdown.


Date of test July 1951

If Flowing Well: Measured discharge _____ g.p.m. on _____
(Date)

Shut-in pressure at ground surface _____ lbs. per sq. in. on _____
(Date)

Water is controlled by _____
(Cap, valve, etc.)

Township 145 Range 4W, W.M. *See Attached map.*
North

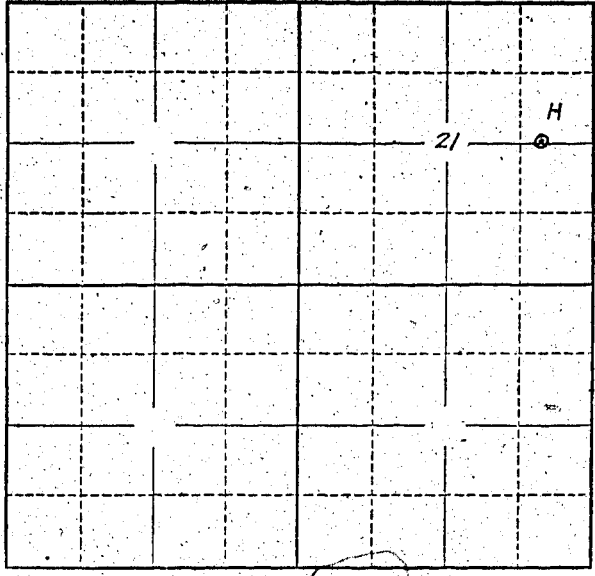

Locate well and acreage of irrigated land on plat.
Scale: 2" = 1 Mile

STATE OF OREGON

County of Linn } ss.

I, Chris Scheffel being first duly sworn, do hereby certify that I have read the foregoing Registration Statement and that all of the items therein contained are true to the best of my knowledge and belief.

Chris Scheffel

(Signature of Registrant)

Subscribed and sworn to before me this 18th day of July, 1958.

My commission expires Sept. 25th, 1959

[Signature]

(Notary Public)

(SEAL)

CERTIFICATE OF REGISTRATION

STATE OF OREGON

County of Marion } ss.

This is to certify that the foregoing Registration Statement was received in the office of the State Engineer on the 24th day of July, 1958, at 8:00 o'clock A.M. and has been duly recorded in said office in Book No. 11 of Registration Statements on page GR-2462

Witness my hand this 6th day of April, 1959

Lewis A. Stanley

(State Engineer)

\$15.00

By _____
(Deputy)