

Registration Statement

OF CLAIMANT OF RIGHT TO APPROPRIATE GROUND WATER

TO THE STATE ENGINEER OF OREGON:

I, Arnold Barzee
of Rte 1 Box 107 Corvallis County of Benton
(Mailing address)

State of Oregon do hereby make application for a certificate of registration as evidence of a right to appropriate ground water.

✓ 1. Source from which water is withdrawn is Pump well
(Flowing well, pump well, infiltration trench, or tunnel)

✓ 2. Location is: 1 1/2 miles north of Corvallis Ore
(Approximate distance and direction from nearest city or town)

and is more particularly described as follows:

(a) ✓ 685' W + 5336' N of SW cor. D.L.C. 51
(Give distance and bearing to corner of section or other legal subdivision)

being within NW 1/4 of NW 1/4 of Sec. 25, Twp. 11 S, Rge. 5 W
(Smallest legal subdivision) (N. or S.) (E. or W.)

or (b) within limits of recorded platted property, town or city:

in Lot 6, Block _____ of Williamette Dale Farms
(Name of plat or addition)

Corvallis County of Benton
(If within city or town, give name)

✓ 3. Construction Work was begun on Aug 1952; was completed on Sept 1952
(Date) (Date)

and the ground water claimed was first used for the purposes set out below on July 1952
(Date)

since which time the water has been used _____
(Continuously or Intermittently)

from June 1952 to July 1952
(Date) (Date)

4. Quantity of water claimed and used is 150 gallons per minute; 40 acre feet per year.

5. Purpose or Purposes for which water is used Irrigation
(Domestic, irrigation, municipal, manufacturing, industrial, etc.)

✓ 6. Description of Well: Depth 48 feet. Type Drilled
(Dug or drilled)

diameter 8 inches. Elevation of ground at well site 30 feet, mean sea level.
(As near as known)

Depth to water table 20 feet.

7. Capacity of Well: 150 g.p.m. with 13 feet drawdown.

_____ g.p.m. with _____ feet drawdown.

Date of test Sept 3 1952

If Flowing Well: Measured discharge _____ g.p.m. on _____
(Date)

Shut-in pressure at ground surface _____ lbs. per sq. in. on _____
(Date)

Water is controlled by _____
(Cap. valve, etc.)

8. Casing: (Give diameter, commercial specifications and depth below ground surface of each casing size.)

✓ 8 inch diameter Standard well casing from 0 to 48 feet
 inch diameter from to feet
 inch diameter from to feet
 inch diameter from to feet

Describe and show depth of shoe, plug, adapter, liner or other details:

✓ 9. Perforated Casings or Screens:

10' - 8 Rows Mill Perforations from 35' to 46'
 (Number per foot and size of perforations, or describe screen)
 from to
 from to
 from to

10. Log of Well: (Describe each stratum or formation clearly, indicate if water bearing, and give thickness and depth as indicated.)

MATERIAL	Thickness (Feet)	Depth to Bottom (Feet)
Clay	0-30'	30'
Sand	30-33'	33'
Gravel bearing water	33-47'	47'
Clay		47'

If log of well is not available, give name and address of driller.

11. Infiltration Trench: Covered or open

Dimensions: Length ft. Minimum depth ft. Maximum depth ft.

Bottom width ft. Discharge g.p.m. Date of test

12. Tunnel: Type of lining

Dimensions:
(Length, course, and cross sectional size)

Position of water bearing stratum with reference to portal of tunnel

Log of tunnel: (Preceding table for log of well may be used, if desired. Give footage from portal and character of materials, as pertinent.)

13. Pumping Equipment:

✓ (a) Pump *Fairbanks-Morse 4-stage turbine* Capacity *150* g.p.m.
(Make, type and size)

✓ (b) Motor *3 ph 10 hp vertical*
(Type and horsepower)


40' 3' column - sh

14. Location of area irrigated or to be irrigated, or place of use if for purposes other than irrigation.

Township North or South	Range E. or W. of Willamette Meridian	Section	Forty-acre Tract	Number Acres To Be Irrigated	Date of Reclamation
<i>11S</i>	<i>5W</i>	<i>25</i>	<i>NW 1/4 - E. NW 1/4</i>	<i>20.0</i>	<i>1953</i>

15. If the ground water supply is supplemental to an existing water supply, identification of any application for a permit, permit, certificate or adjudicated right to appropriate water made or held by the registrant.

Township 11S Range 5W, W.M.
North

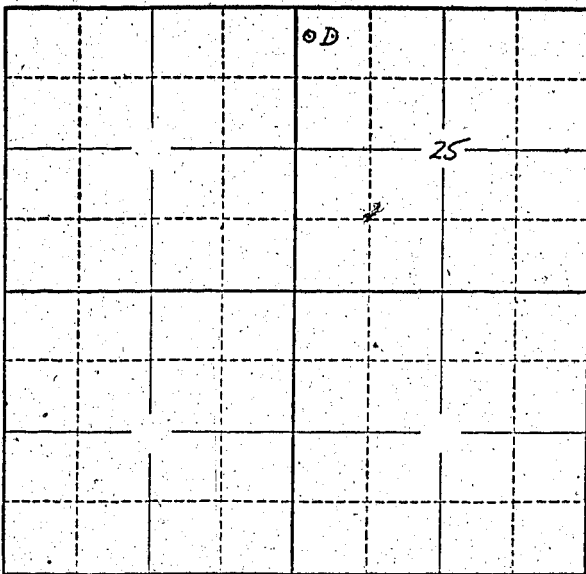

Locate well and acreage of irrigated land on plat.
Scale: 2" = 1 Mile

STATE OF OREGON

County of Marion

} ss.

I, Donald W. [unclear], being first duly sworn, do hereby certify that I have read the foregoing Registration Statement and that all of the items therein contained are true to the best of my knowledge and belief.

(Signature of Registrant)

Subscribed and sworn to before me this 22nd day of July, 1958.

My commission expires April 5, 1962

(Notary Public)

(SEAL)

CERTIFICATE OF REGISTRATION

STATE OF OREGON

County of Marion

} ss.

This is to certify that the foregoing Registration Statement was received in the office of the State Engineer on the 24th day of July, 1958, at 8:00 o'clock A. M. and has been duly recorded in said office in Book No. 11 of Registration Statements on page GR-2465

Witness my hand this 6th day of April, 1959.

(State Engineer)

By

(Deputy)

GR - 2465