

Registration Statement

OF CLAIMANT OF RIGHT TO APPROPRIATE GROUND WATER

(Under Chapter 708, Oregon Laws 1955.)

TO THE STATE ENGINEER OF OREGON:

I, V. H. Thompson

of Dayton County of Yamhill

State of Oregon, do hereby make application for a certificate of registration as evidence of a right to appropriate ground water.

1. Source from which water is withdrawn is pump well
(Flowing well, pump well, infiltration trench, or tunnel)

2. Location is: 1 1/2 miles South of Dayton, Oregon
(Approximate distance and direction from nearest city or town)

and is more particularly described as follows:

(a) 29 chains W. and 1 rod N. of the SE corner of
(Give distance and bearing to corner of section or other legal subdivision)

being within SE 1/4 SW 1/4 SE 1/4 of Sec. 21, Twp. 4 S, Rge. 3 W, W.M. W.M.
(Smallest legal subdivision) (N. or S.) (E. or W.)

or (b) within limits of recorded platted property, town or city:

in Lot _____, Block _____ of _____
(Name of plat or addition)

County of _____
(If within city or town, give name)

3. Construction Work was begun on July 1, 1952, was completed on Aug 15, 1952
(Date) (Date)

and the ground water claimed was first used for the purposes set out below on Aug 25, 1952
(Date)

since which time the water has been used intermittently
(Continuously or intermittently)

from Aug 25, 1952 to Sept. 30, 1955
(Date) (Date)

4. Quantity of water claimed and used is 300 gallons per minute; 140 acre feet per year.

5. Purpose or Purposes for which water is used Irrigation

(Domestic, irrigation, municipal, manufacturing, industrial, etc.)

6. Description of Well: Depth 160 feet. Type Drilled
(Dug or drilled)

diameter 8 inches. Elevation of ground at well site 140 feet, mean sea level.
(As near as known)

Depth to water table 35 feet.

7. Capacity of Well: 350 g.p.m. with 80 feet drawdown.
_____ g.p.m. with _____ feet drawdown.

Date of test Aug 1, 1952

If Flowing Well: Measured discharge _____ g.p.m. on _____
(Date)

Shut-in pressure at ground surface _____ lbs. per sq. in. on _____
(Date)

Water is controlled by _____
(Cap, valve, etc.)

8. Casing: (Give diameter, commercial specifications and depth below ground surface of each casing size.)

8 inch diameter from 0 to 160 feet
inch diameter from to feet
inch diameter from to feet
inch diameter from to feet

Describe and show depth of shoe, plug, adapter, liner or other details: none

9. Perforated Casings or Screens:

Linear slots 3/8" wide from 80 to 160
(Number per foot and size of perforations, or describe screen)
..... from to
..... from to
..... from to

10. Log of Well: (Describe each stratum or formation clearly, indicate if water bearing, and give thickness and depth as indicated.)

MATERIAL	Thickness (Feet)	Depth to Bottom (Feet)
Clay	35	35
Sand	5	40
Clay	35	75
Sand	20	95
Clay	40	135
Sand	25	160

If log of well is not available, give name and address of driller.

Wilcox Drilling Co.

M^s Minnville, Oregon

11. Infiltration Trench: Covered or open

Dimensions: Length ft. Minimum depth ft. Maximum depth ft.

Bottom width ft. Discharge g.p.m. Date of test

12. Tunnel: Type of lining

Dimensions:
(Length, course, and cross sectional size)

Position of water bearing stratum with reference to portal of tunnel

Log of tunnel: (Preceding table for log of well may be used, if desired. Give footage from portal and character of materials, as pertinent.)

13. Pumping Equipment:

(a) Pump Pomona Turbine 4" dis. Capacity 300 g.p.m.
(Make, type and size)


(b) Motor Vertical shaft Electric 25hp
(Type and horsepower)

14. Location of area irrigated or to be irrigated, or place of use if for purposes other than irrigation.

Township North or South	Range E. or W. of Willamette Meridian	Section	Forty-acre Tract	Number Acres To Be Irrigated	Date of Reclamation
4S	3W	21	SE $\frac{1}{4}$ NW $\frac{1}{4}$	5	Aug 25, 1952
4S	3W	21	SW $\frac{1}{4}$ NE $\frac{1}{4}$	5	Aug 25, 1952
4S	3W	21	NE $\frac{1}{4}$ SW $\frac{1}{4}$	20	Aug 25, 1952
4S	3W	21	NW $\frac{1}{4}$ SE $\frac{1}{4}$	20	Aug 25, 1952
4S	3W	21	SE $\frac{1}{4}$ SW $\frac{1}{4}$	2	Aug 25, 1952
4S	3W	21	SW $\frac{1}{4}$ SE $\frac{1}{4}$	3	Aug 25, 1952
				55	

15. If the ground water supply is supplemental to an existing water supply, identification of any application for a permit, permit, certificate or adjudicated right to appropriate water made or held by the registrant.

Township 4S Range 3W W.M.
North

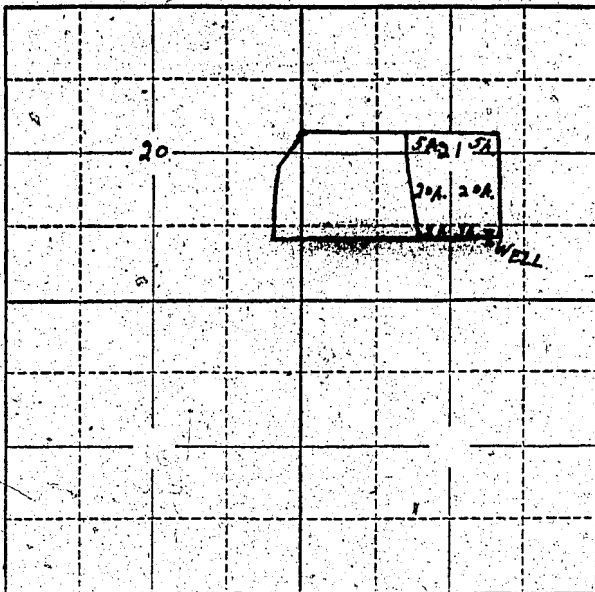

Locate well and acreage of irrigated land on plat.
Scale: 2" = 1 Mile

STATE OF OREGON

County of Yamhill } ss.

I, W. H. Thompson, being first duly sworn, do hereby certify that I have read the foregoing Registration Statement and that all of the items therein contained are true to the best of my knowledge and belief.

W. H. Thompson
(Signature of Registrant)

Subscribed and sworn to before me this 13 day of October, 1955

My commission expires March 22, 1959 Viola Francis
(Notary Public)

(SEAL)

CERTIFICATE OF REGISTRATION

STATE OF OREGON

County of Marion } ss.

This is to certify that the foregoing Registration Statement was received in the office of the State Engineer on the 17th day of October, 1955, at 1:00 o'clock P. M. and has been duly recorded in said office in Book No. 1 of Registration Statements on page 22

Construction shall be completed by _____, 19____, and the water completely applied to beneficial use by _____, 19____.

Witness my hand this 24th day of February, 1956

Lewis G. Stanley
(State Engineer)

By _____
(Deputy)