

# Registration Statement

## OF CLAIMANT OF RIGHT TO APPROPRIATE GROUND WATER

TO THE STATE ENGINEER OF OREGON:

We I, Roy and Dorothy Areta  
of Rt. 5 Box 448 Oregon City County of Clackamas  
(Mailing address)

State of Oregon, do hereby make application for a certificate of registration as evidence of a right to appropriate ground water.

1. Source from which water is withdrawn is Pump well  
(Flowing well, pump well, infiltration trench, or tunnel)

2. Location is: 8 miles N.E. of Oregon City  
(Approximate distance and direction from nearest city or town)

and is more particularly described as follows: Beginning at the S.E. corner Wm. Arthur D.L.C. in Sec's 19 & 20 T2S R3E W1. Thence N 10° 0' E 1284.36', Thence N79° 08' W 660'.

(a) Thence N 10° 0' E 660' to the wall  
(Give distance and bearing to corner of section or other legal subdivision)  
being within the Wm. Arthur D.L.C. situated in 2 S., Rge. 3 E.  
(Smallest legal subdivision) (N. or S.) (E. or W.)

or (b) within limits of recorded platted property, town or city:  
in Lot \_\_\_\_\_, Block \_\_\_\_\_ of \_\_\_\_\_  
(Name of plat or addition)

County of \_\_\_\_\_  
(If within city or town, give name)

3. Construction Work was begun on 10-24-51; was completed on 11-24-51  
(Date) (Date)

and the ground water claimed was first used for the purposes set out below on 4-1-52  
(Date)

since which time the water has been used intermittently  
(Continuously or intermittently)

from 4-1-52 to 7-18-58  
(Date) (Date)

4. Quantity of water claimed and used is 200 gallons per minute; \_\_\_\_\_ acre feet per year.

5. Purpose or Purposes for which water is used Irrigation for general farming  
(Domestic, irrigation, municipal, manufacturing, industrial, etc.)

6. Description of Well: Depth 172 feet. Type Drilled  
(Dug or drilled)  
diameter 8 inches. Elevation of ground at well site 300 feet, mean sea level.  
(As near as known)  
Depth to water table 90 feet.

7. Capacity of Well: 150 g.p.m. with 93 feet drawdown.  
200 g.p.m. with 93 feet drawdown.

Date of test 11-24-51

If Flowing Well: Measured discharge \_\_\_\_\_ g.p.m. on \_\_\_\_\_  
(Date)


Shut-in pressure at ground surface \_\_\_\_\_ lbs. per sq. in. on \_\_\_\_\_  
(Date)

Water is controlled by \_\_\_\_\_  
(Cap, valve, etc.)





Township 25 Range 3E, W.M.  
North

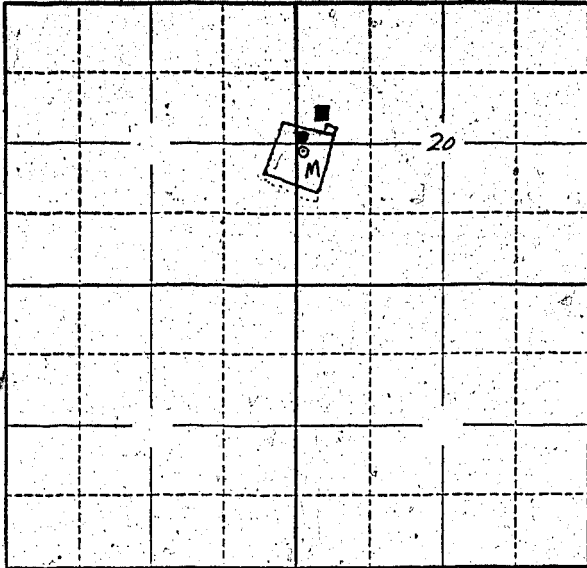

Locate well and acreage of irrigated land on plat.  
Scale: 2" = 1 Mile

STATE OF OREGON

County of Subamas } ss.

W. Roy & Dorothy Anita, being first duly sworn, do hereby certify that I have read the foregoing Registration Statement and that all of the items therein contained are true to the best of my knowledge and belief.

W. Roy & Dorothy Anita  
(Signature of Registrant)

Subscribed and sworn to before me this 23rd day of July, 1958

My commission expires Jan. 17, 1961  
Katherine Kowalke  
(Notary Public)

(SEAL)

**CERTIFICATE OF REGISTRATION**

STATE OF OREGON } ss.  
County of Marion

This is to certify that the foregoing Registration Statement was received in the office of the State Engineer on the 24th day of July, 1958, at 8:00 o'clock A. M. and has been duly recorded in said office in Book No. 11 of Registration Statements on page GR 2469

Witness my hand this 6th day of April, 1959

Lewis A. Stanley  
(State Engineer)

By \_\_\_\_\_  
(Deputy)

\$1500

GR - 2469