

Registration Statement

OF CLAIMANT OF RIGHT TO APPROPRIATE GROUND WATER

TO THE STATE ENGINEER OF OREGON:

I, Jesse R. Ellis

of 1462 Poplar Drive Medford, Oregon County of Jackson

(Mailing address)

State of Oregon do hereby make application for a certificate of registration as evidence of a right to appropriate ground water.

1. Source from which water is withdrawn is Pump Well
(Flowing well, pump well, infiltration trench, or tunnel)

2. Location is: Within city limits of Medford, Oregon
(Approximate distance and direction from nearest city or town)

and is more particularly described as follows:

(a) _____
(Give distance and bearing to corner of section or other legal subdivision)

being within _____ of Sec. _____, Twp. _____, Rge. _____
(Smallest legal subdivision) (N. or S.) (E. or W.)

or (b) within limits of recorded platted property, town or city: _____

in Lot _____, Block _____ of _____
(Name of plat or addition)

Medford County of Jackson

(If within city or town, give name)

3. Construction Work was begun on 1953; was completed on 1953
(Date) (Date)

and the ground water claimed was first used for the purposes set out below on 1953
(Date)

since which time the water has been used Continuously
(Continuously or intermittently)

from 1953 to Present
(Date) (Date)

4. Quantity of water claimed and used is 40 gallons per minute; 14 acre feet per year.

5. Purpose or Purposes for which water is used Irrigation

(Domestic, irrigation, municipal, manufacturing, industrial, etc.)

6. Description of Well: Depth 12 feet. Type Dug
(Dug or drilled)

diameter 36" inches. Elevation of ground at well site 1325 feet, mean sea level.
(As near as known)

Depth to water table 2.0' feet.

7. Capacity of Well: 40 g.p.m. with 10 feet drawdown in 30 Min.

_____ g.p.m. with _____ feet drawdown.

Date of test Noted from Use

If Flowing Well: Measured discharge _____ g.p.m. on _____
(Date)

Shut-in pressure at ground surface _____ lbs. per sq. in. on _____
(Date)

Water is controlled by _____
(Cap, valve, etc.)

8. (Casing: (Give diameter, commercial specifications and depth below ground surface of each casing size.)

6" inch diameter Concrete Tile from 0 to 8' feet
 36" inch diameter Concrete Tile from 8 to 12' feet
 inch diameter from to feet
 inch diameter from to feet

Describe and show depth of shoe, plug, adapter, liner or other details: None

9. Perforated Casings or Screens:

8 1 1/2" Perforations Per Foot. (Est.) from 8' to 12' feet
 (Number per foot and size of perforations, or describe screen)

10. Log of Well: (Describe each stratum or formation clearly, indicate if water bearing, and give thickness and depth as indicated.)

MATERIAL	Thickness (Feet)	Depth to Bottom (Feet)
Top Soil (Black Clay Loam)	11'	1'
Medium Gravel	1'	0'

If log of well is not available, give name and address of driller. City Sanitation Service
Medford, Oregon

11. Infiltration Trench: Covered or open _____
Dimensions: Length _____ ft. Minimum depth _____ ft. Maximum depth _____ ft.
Bottom width _____ ft. Discharge _____ g.p.m. Date of test _____

12. Tunnel: Type of lining _____
Dimensions: _____
(Length, course, and cross sectional size)
Position of water bearing stratum with reference to portal of tunnel _____

Log of tunnel: (Preceding table for log of well may be used, if desired. Give footage from portal and character of materials, as pertinent.)

13. Pumping Equipment:

(a) Pump Carver 1 $\frac{1}{2}$ " Centrifugal _____ Capacity 80 g.p.m.
(Make, type and size)
(b) Motor 1 $\frac{1}{2}$ HP Electric Motor _____
(Type and horsepower)


14. Location of area irrigated or to be irrigated, or place of use if for purposes other than irrigation.

Township North or South	Range E. or W. of Willamette Meridian	Section	Forty-acre Tract	Number Acres To Be Irrigated	Date of Reclamation
37 S	1 W	19	NW $\frac{1}{4}$ of NE $\frac{1}{4}$ Of NW $\frac{1}{4}$ of Sec. 19 TW 37 S. R 1W. Well Located in Center of Property.	3	1953

15. If the ground water supply is supplemental to an existing water supply, identification of any application for a permit, permit, certificate or adjudicated right to appropriate water made or held by the registrant.
None

Township 37 S Range 1 W W.M.

North

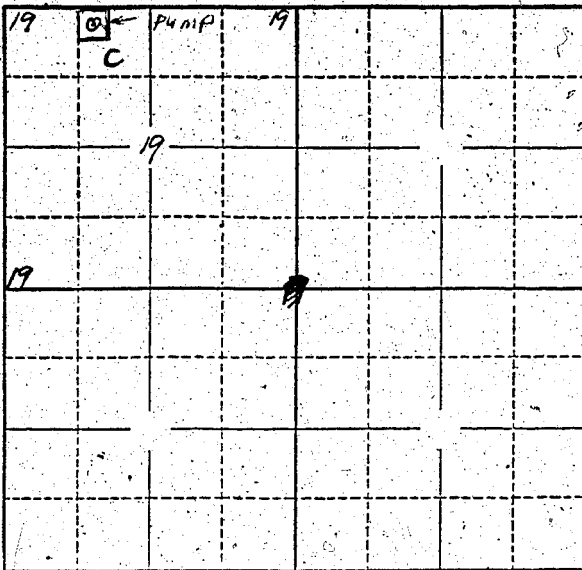

Locate well and acreage of irrigated land on plat.

Scale: 2" = 1 Mile

STATE OF OREGON


I, Jesse R. Ellis, being first duly sworn, do hereby certify that I have read the foregoing Registration Statement and that all of the items therein contained are true to the best of my knowledge and belief.

Jesse R. Ellis
(Signature of Registrant)

Subscribed and sworn to before me this 3 day of July, 1958

My commission expires May 25 1959 Quentin J. [unclear]
(Notary Public)

(SEAL)

CERTIFICATE OF REGISTRATION

STATE OF OREGON

County of Marion } ss.

This is to certify that the foregoing Registration Statement was received in the office of the State Engineer on the 24 day of July, 1958, at 8:00 o'clock A.M. and has been duly recorded in said office in Book No. 11 of Registration Statements on page GR-2470

Witness my hand this 6th day of April, 1959

Lawrence A. Stanley
(State Engineer)

\$15.00

By _____
(Deputy)