

Registration Statement

OF CLAIMANT OF RIGHT TO APPROPRIATE GROUND WATER

TO THE STATE ENGINEER OF OREGON:

I, E. O. Reinking

of 313 1/4 Beall Lane, Central Point, Oregon County of Jackson

State of Oregon, do hereby make application for a certificate of registration as evidence of a right to appropriate ground water.

1. Source from which water is withdrawn is Infiltration trench (sump)
(Flowing well, pump well, infiltration trench, or tunnel)

2. Location is: 2 miles west of Central Point, Oregon
(Approximate distance and direction from nearest city or town)

and is more particularly described as follows:

(a) 25 feet south and 1155 feet west from the SE corner DIC #45
(Give distance and bearing to corner of section or other legal subdivision)

being within SW 1/4 NE 1/4 SW 1/4 of Sec. 9, Twp. 37S, Rge. 2W (WM)
(Smallest legal subdivision) (N or S) (E or W)

or (b) within limits of recorded platted property, town or city:

in Lot _____, Block _____ of _____
(Name of plat or addition)
County of _____
(If within city or town, give name)

3. Construction Work was begun on May, 1947; was completed on May, 1947
(Date) (Date)

and the ground water claimed was first used for the purposes set out below on June, 1947
(Date)

since which time the water has been used Intermittently
(Continuously or intermittently)

from June, 1947 to July, 1958
(Date) (Date)

4. Quantity of water claimed and used is 100 gallons per minute; 45 acre feet per year.

5. Purpose or Purposes for which water is used Irrigation

6. Description of ~~Well~~ ^{SUMP} Depth 18 feet. Type Dug
(Domestic, irrigation, municipal, manufacturing, industrial, etc.) (Dug or drilled)

diameter 12' x 15' ~~inches~~. Elevation of ground at well site 1370 feet, mean sea level.
(As near as known)

Depth to water table 10' feet.

7. Capacity of Well: _____ g.p.m. with _____ feet drawdown.

_____ g.p.m. with _____ feet drawdown.


Date of test _____

If Flowing Well: Measured discharge _____ g.p.m. on _____
(Date)

Shut-in pressure at ground surface _____ lbs. per sq. in. on _____
(Date)

Water is controlled by _____
(Cap, valve, etc.)

Township 37 S. Range 2 W., W.M.
North

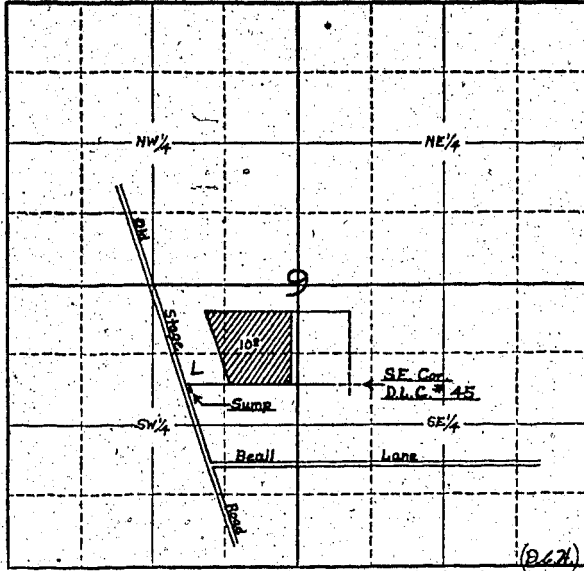

Locate well and acreage of irrigated land on plat.
Scale: 4" = 1 Mile

STATE OF OREGON }
County of Jackson } ss.

I, E. O. Reinking, being first duly sworn, do hereby certify that I have read the foregoing Registration Statement and that all of the items therein contained are true to the best of my knowledge and belief.

E. O. Reinking
.....
(Signature of Registrant)

Subscribed and sworn to before me this 23rd day of July, 1958.

My commission expires August 25, 1958.

[Signature]
.....
(Notary Public)

(SEAL)

CERTIFICATE OF REGISTRATION

STATE OF OREGON }
County of Marion } ss.

This is to certify that the foregoing Registration Statement was received in the office of the State Engineer on the 24 day of July, 1958, at 8:00 o'clock A.M. and has been duly recorded in said office in Book No. 11 of Registration Statements on page GR 2472

Witness my hand this 6th day of April, 1959

[Signature]
.....
(State Engineer)

By
(Deputy)

\$15.00

GR - 2472