

Registration Statement

REGISTRATION NO. GR-2607

CERTIFICATE NO. GR-2474

OF CLAIMANT OF RIGHT TO APPROPRIATE GROUND WATER

(Under Chapter 708, Oregon Laws 1955.)

TO THE STATE ENGINEER OF OREGON:

I, C.R. Hodges of Rt #1 Box 476 Garden Rd Corvallis Benton County of Oregon State of Oregon, do hereby make application for a certificate of registration as evidence of a right to appropriate ground water.

- 1. Source from which water is withdrawn is pump well (Flowing well, pump well, infiltration trench, or tunnel)
2. Location is: 3 miles North of Corvallis, Ore. (Approximate distance and direction from nearest city or town)

and is more particularly described as follows:

(a) S. 8° 51 1/2' N. 15,987 chs. from west E. N. E. cor. 1st Street being within SW 1/4 of S. E. 1/4 of Sec. 19, Twp. 11 S., Rge. 4 W. (Give distance and bearing to corner of section or other legal subdivision) (Smallest legal subdivision) (N. or S.) (E. or W.)

(b) within limits of recorded platted property, town or city: in Lot, Block of County of Benton (Name of plat or addition) (If within city or town, give name)

3. Construction Work was begun on Nov 1942; was completed on Nov 1942 (Date) (Date)

and the ground water claimed was first used for the purposes set out below on Nov 1943 (Date) since which time the water has been used intermittently (Continuously or Intermittently) from 1942 to 1958 (Date) (Date)

4. Quantity of water claimed and used is 30 10-8 gal sprinker gallons per minute; 10 acre feet per year.

5. Purpose or Purposes for which water is used Irrigation

6. Description of Well: Depth 44 feet. Type Drilled (Domestic, irrigation, municipal, manufacturing, industrial, etc.) (Dug or drilled) diameter 8 inches. Elevation of ground at well site 215 feet, mean sea level. (As near as known) Depth to water table 8 feet.

7. Capacity of Well: 150 g.p.m. with 2 feet drawdown. g.p.m. with feet drawdown.

Date of test

If Flowing Well: Measured discharge g.p.m. on (Date)

8 Shut-in pressure at ground surface lbs. per sq. in. on (Date)

Water is controlled by (Cap, valve, etc.)

8. Casing: (Give diameter, commercial specifications and depth below ground surface of each casing size.)

8 inch diameter from to feet
 inch diameter *Information* from to feet
 inch diameter *unobtainable* from to feet
 inch diameter from to feet

Describe and show depth of shoe, plug, adapter, liner or other details:


9. Perforated Casings or Screens:

(Number per foot and size of perforations, or describe screen) from to
 from to
Information unobtainable from to
 from to

10. Log of Well: (Describe each stratum or formation clearly, indicate if water bearing, and give thickness and depth as indicated.)

MATERIAL	Thickness (Feet)	Depth to Bottom (Feet)
<i>Information unobtainable</i>		

Township 11S Range 4W, W.M.
North

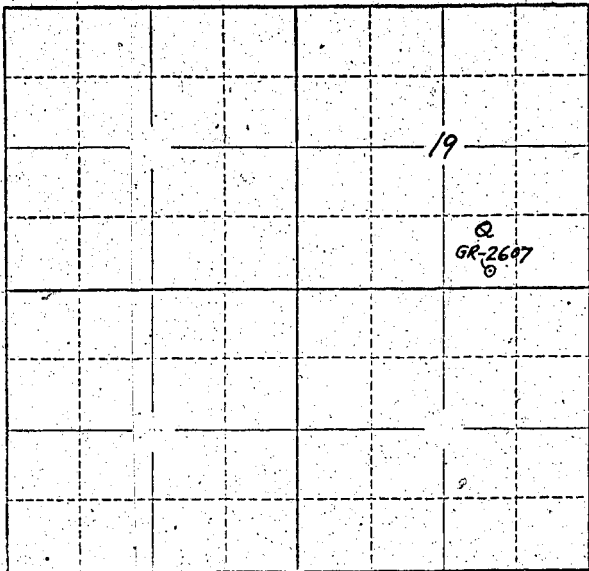

Locate well and acreage of irrigated land on plat.
Scale: 2" = 1.Mile

STATE OF OREGON

County of DeLone } ss.

I, Charles R. Hodges being first duly sworn, do hereby certify that I have read the foregoing Registration Statement and that all of the items therein contained are true to the best of my knowledge and belief.

Charles R. Hodges
(Signature of Registrant)

Subscribed and sworn to before me this 23 day of July, 1958

My commission expires August 20, 1960 Walter G. ...
(Notary Public)

(SEAL)

CERTIFICATE OF REGISTRATION

STATE OF OREGON

County of Marion } ss.

This is to certify that the foregoing Registration Statement was received in the office of the State Engineer on the 24th day of July, 1958, at 8:00 o'clock A.M. and has been duly recorded in said office in Book No. 11 of Registration Statements on page GR 2474

~~Construction shall be completed by ... and the water consistently applied to the ...~~

Witness my hand this 6th day of April, 1959

Arthur A. Attenley
(State Engineer)

\$15.00

By _____ (Deputy)

GR-2474