Registration No. GR-2608

Certificate No. GR-2475

# Registration Statement

## OF CLAIMANT OF RIGHT TO APPROPRIATE GROUND WATER

**TO THE STATE ENGINEER OF OREGON:**

I, E. D. FURRER,

of 2432 City View Rd. EUGENE (Mailing address) County of LANE

State of ORE, do hereby make application for a certificate of registration as evidence of a right to appropriate ground water.

1. **Source** from which water is withdrawn is PUMP WELL (Flowing well, pump well, infiltration trench, or tunnel)

2. **Location is:** 3 MILE SW FROM COURT HOUSE IN EUGENE (Approximate distance and direction from nearest city or town);

and is more particularly described as follows:

(a) 586'S & 60' West of East ¼ cor sec 2 T18S, R4W (Give distance and bearing to corner of section or other legal subdivision)

being within NE¼ of SE¼ (Smallest legal subdivision) of Sec. 2, Twp. 18 S (N. or S.), Rge. R4W (E. or W.)

or (b) within limits of recorded platted property, town or city:

in Lot ....., Block ..... of ..... (Name of plat or addition)

..... (If within city or town, give name) County of LANE

3. **Construction Work** was begun on 1938 (Date); was completed on 1938 (Date)

and the ground water claimed was first used for the purposes set out below on 1938 (Date),

since which time the water has been used ✓ (Continuously or intermittently)

from ALL YR. (Date) to ..... (Date)

4. **Quantity** of water claimed and used is 20 gallons per minute; 5 acre feet per year.

5. **Purpose or Purposes** for which water is used IRRIG. ~~[illegible]~~

~~[illegible]~~ (Domestic, irrigation, municipal, manufacturing, industrial, etc.)

6. **Description of Well:** Depth 68 feet. Type DRILL (Dug or drilled)

diameter 6 inches. Elevation of ground at well site 525 (As near as known) feet, mean sea level.

Depth to water table 40 feet.

7. **Capacity of Well:** 20 g.p.m. with 22 feet drawdown.

..... g.p.m. with ..... feet drawdown.

Date of test 1950

**If Flowing Well:** Measured discharge ..... g.p.m. on ..... (Date)

Shut-in pressure at ground surface ..... lbs. per sq. in. on ..... (Date)

Water is controlled by ..... (Cap, valve, etc.)

8. **Casing:** (Give diameter, commercial specifications and depth below ground surface of each casing size.)

6 inch diameter IRON from 0 to 30 feet

..... inch diameter ..... from ..... to ..... feet

..... inch diameter ..... from ..... to ..... feet

..... inch diameter ..... from ..... to ..... feet

Describe and show depth of shoe, plug, adapter, liner or other details: .....

9. **Perforated Casings or Screens:**

NONE from ..... to .....
(Number per foot and size of perforations, or describe screen)

..... from ..... to .....

..... from ..... to .....

..... from ..... to .....

10. **Log of Well:** (Describe each stratum or formation clearly, indicate if water bearing, and give thickness and depth as indicated.)

| MATERIAL | Thickness (Feet) | Depth to Bottom (Feet) |
|---|---|---|
| NONE | | |

GR 2475

If log of well is not available, give name and address of driller. A.F. Moody
370 River Rd Eugene Ore

11. **Infiltration Trench:** Covered or open .....

Dimensions: Length ..... ft. Minimum depth ..... ft. Maximum depth ..... ft.

Bottom width ..... ft. Discharge ..... g.p.m. Date of test .....

12. **Tunnel:** Type of lining .....

Dimensions: .....
(Length, course, and cross sectional size)

Position of water bearing stratum with reference to portal of tunnel .....

Log of tunnel: (Preceding table for log of well may be used, if desired. Give footage from portal and character of materials, as pertinent.)

13. **Pumping Equipment:**

(a) Pump BERKLEY Jet 1¼ x 1¼ Capacity 20 g.p.m.
(Make, type and size)

(b) Motor " 2 HP Elec Single Phase
(Type and horsepower)

14. Location of area irrigated or to be irrigated, or place of use if for purposes other than irrigation.

| Township North or South | Range E. or W. of Willamette Meridian | Section | Forty-acre Tract | Number Acres To Be Irrigated | Date of Reclamation |
|---|---|---|---|---|---|
| See attached Platt City View Park Lane County | | | | | |
| 18 S | 4 W | 2 | NE¼, SE¼ | 5.0 Ac | 1938 |

15. If the ground water supply is supplemental to an existing water supply, identification of any application for a permit, permit, certificate or adjudicated right to appropriate water made or held by the registrant.

.....

.....

Township 18 S Range 4W, W.M.

North

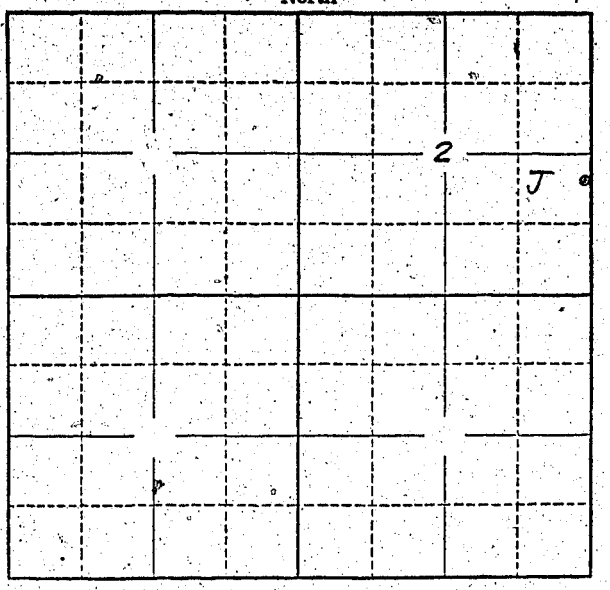


Locate well and acreage of irrigated land on plat.

Scale: 2" = 1 Mile

STATE OF OREGON
County of Lane } ss.

I, E. D. FURRER, being first duly sworn, do hereby certify that I have read the foregoing Registration Statement and that all of the items therein contained are true to the best of my knowledge and belief.

E D Furrer
(Signature of Registrant)

Subscribed and sworn to before me this 24th day of June, 1958

My commission expires My Commission Expires Jan. 6, 1962 Lona Plotts
(Notary Public)

(SEAL)

## CERTIFICATE OF REGISTRATION

STATE OF OREGON
County of Marion } ss.

This is to certify that the foregoing Registration Statement was received in the office of the State Engineer on the 24th day of July, 1958, at 8:00 o'clock A M. and has been duly recorded in said office in Book No. 11 of Registration Statements on page GR 2475

Witness my hand this 6th day of April, 1959

Lewis A. Stanley
(State Engineer)

$1.50

By
(Deputy)

GR-2475