

Registration Statement

OF CLAIMANT OF RIGHT TO APPROPRIATE GROUND WATER

TO THE STATE ENGINEER OF OREGON:

I, Frank X. Gallagher
of 1900 Beacon Drive Eugene County of Lane
State of Ore., do hereby make application for a certificate of registration as evidence
of a right to appropriate ground water.

- 1. Source from which water is withdrawn is Pump Well
(Flowing well, pump well, infiltration trench, or tunnel)
- 2. Location is: 7 Mi. NW of Eugene
(Approximate distance and direction from nearest city or town)

and is more particularly described as follows:

(a) 2960 ft. E. & 1961 ft. S. of NW corner Sec. 1
(Give distance and bearing to corner of section or other legal subdivision)
being within SW 1/4 of NE 1/4 of Sec. 1, Twp. 17S, Rge. 4W
(Smallest legal subdivision) (N. or S.) (E. or W.)

or (b) within limits of recorded platted property, town or city:

in Lot _____, Block _____ of _____
(Name of plat or addition)

_____ County of _____
(If within city or town, give name)

3. Construction Work was begun on 1946; was completed on 1946
(Date) (Date)
and the ground water claimed was first used for the purposes set out below on 1946
(Date)
since which time the water has been used intermittently
(Continuously or Intermittently)
from June 1946 to present
(Date) (Date)

4. Quantity of water claimed and used is 200 gallons per minute; 7.5 acre feet per year.

5. Purpose or Purposes for which water is used irrigation
(Domestic, irrigation, municipal, manufacturing, industrial, etc.)


6. Description of Well: Depth 18 feet. Type Drilled
(Dug or drilled)
diameter 4 inches. Elevation of ground at well site _____ feet, mean sea level.
(As near as known)
Depth to water table ? feet.

7. Capacity of Well: ? g.p.m. with ? feet drawdown.
_____ g.p.m. with _____ feet drawdown.

Date of test _____

If Flowing Well: Measured discharge _____ g.p.m. on _____
(Date)
Shut-in pressure at ground surface _____ lbs. per sq. in. on _____
(Date)
Water is controlled by _____
(Cap, valve, etc.)

Township 17 S Range 4 W, W.M.
North

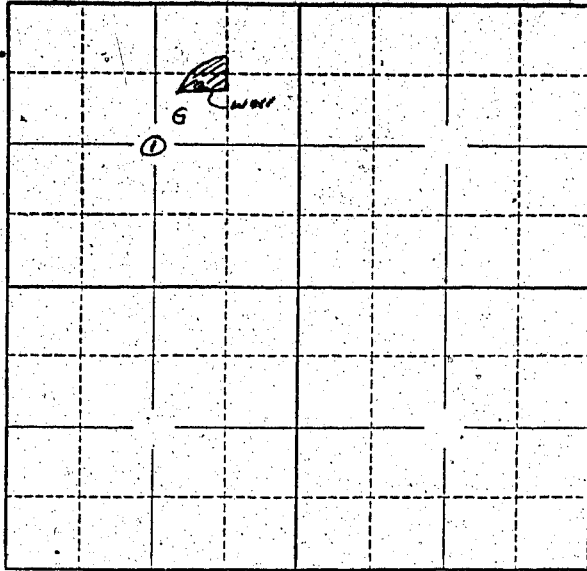

Locate well and acreage of irrigated land on plat.

Scale: 2" = 1 Mile

STATE OF OREGON

County of Lane } ss.

I, FRANK X. GALLAGHER, being first duly sworn, do hereby certify that I have read the foregoing Registration Statement and that all of the items therein contained are true to the best of my knowledge and belief.

Frank X. Gallagher
(Signature of Registrant)

Subscribed and sworn to before me this 14 day of March, 1958

My commission expires June 25, 1961
Luise A. Stanley
(Notary Public)

(SEAL)

CERTIFICATE OF REGISTRATION

STATE OF OREGON }
County of Marion } ss.

This is to certify that the foregoing Registration Statement was received in the office of the State Engineer on the 24 day of July, 1958, at 8:00 o'clock A. M. and has been duly recorded in said office in Book No. 11 of Registration Statements on page GR-2478

Witness my hand this 6th day of April, 1959

Luise A. Stanley
(State Engineer)

\$15.00

By _____ (Deputy)

GR - 2478