

# Registration Statement

## OF CLAIMANT OF RIGHT TO APPROPRIATE GROUND WATER

**TO THE STATE ENGINEER OF OREGON:**

I, J. R. and Vada H. Peterson

of Rt. 2, Box 278, Lebanon County of Linn  
(Mailing address)

State of Oregon, do hereby make application for a certificate of registration as evidence of a right to appropriate ground water:

1. Source from which water is withdrawn is pump well  
(Flowing well, pump well, infiltration trench, or tunnel)

2. Location is: 5 miles NE Lebanon, Oregon  
(Approximate distance and direction from nearest city or town)

and is more particularly described as follows:

(a) N. 62° 52' E. 13.8 chains from SW corner of SE $\frac{1}{4}$  of S. 15, T. 11 S, R. 2 W  
(Give distance and bearing to corner of section or other legal subdivision)

being within SW $\frac{1}{4}$  of SE $\frac{1}{4}$  of Sec. 15, Twp. 11 S, Rge. 2 W  
(Smallest legal subdivision) (N. or S.) (E. or W.)

or (b) within limits of recorded platted property, town or city:

in Lot \_\_\_\_\_, Block \_\_\_\_\_ of \_\_\_\_\_  
(Name of plat or addition)

County of Linn  
(If within city or town, give name)

3. Construction Work was begun on Sept. 12, 1951; was completed on Sept. 14, 1951  
(Date) (Date)

and the ground water claimed was first used for the purposes set out below on May 14, 1951  
(Date)

since which time the water has been used continuously  
(Continuously or Intermittently)

from May 14, 1951 to present time  
(Date) (Date)

4. Quantity of water claimed and used is 96 gallons per minute; 88.5 acre feet per year.

5. Purpose or Purposes for which water is used Irrigation

(Domestic, irrigation, municipal, manufacturing, industrial, etc.)

6. Description of Well: Depth 22 feet. Type Drilled  
(Dug or drilled)

diameter 10 inches. Elevation of ground at well site 290 feet, mean sea level.  
(As near as known)

Depth to water table 10 feet.

7. Capacity of Well: \_\_\_\_\_ g.p.m. with \_\_\_\_\_ feet drawdown.

\_\_\_\_\_ g.p.m. with \_\_\_\_\_ feet drawdown.

Date of test Not Tested

If Flowing Well: Measured discharge \_\_\_\_\_ g.p.m. on \_\_\_\_\_  
(Date)

Shut-in pressure at ground surface \_\_\_\_\_ lbs. per sq. in. on \_\_\_\_\_  
(Date)

Water is controlled by \_\_\_\_\_  
(Cap, valve, etc.)

8. Casing: (Give diameter, commercial specifications and depth below ground surface of each casing size.)

10 inch diameter steel casing from 0 to 20 feet  
 inch diameter from to feet  
 inch diameter from to feet  
 inch diameter from to feet

Describe and show depth of shoe, plug, adapter, liner or other details:  
 .....  
 .....

9. Perforated Casings or Screens:

Slot perforations from 15 to 20  
(Number per foot and size of perforations, or describe screen)  
 ..... from ..... to .....  
 ..... from ..... to .....  
 ..... from ..... to .....

10. Log of Well: (Describe each stratum or formation clearly, indicate if water bearing, and give thickness and depth as indicated.)

MATERIAL	Thickness (Feet)	Depth to Bottom (Feet)
Not available		

If log of well is not available, give name and address of driller. Bill Hamilton Drilling Co.,

838 E. Third Ave., Albany, Oregon

11. Infiltration Trench: Covered or open .....

Dimensions: Length ..... ft. Minimum depth ..... ft. Maximum depth ..... ft.

Bottom width ..... ft. Discharge ..... g.p.m. Date of test .....

12. Tunnel: Type of lining .....

Dimensions: .....  
(Length, course, and cross sectional size)

Position of water bearing stratum with reference to portal of tunnel .....

Log of tunnel: (Preceding table for log of well may be used, if desired. Give footage from portal and character of materials, as pertinent.)

13. Pumping Equipment:

(a) Pump Fairbanks Morse 1" centrifugal Capacity 125 g.p.m.  
(Make, type and size)

(b) Motor 5 H. P. electric  
(Type and horsepower)

14. Location of area irrigated or to be irrigated, or place of use if for purposes other than irrigation.


Township North, or South	Range E. or W. of Williams to Meridian	Section	Forty-acre Tract	Number Acres To Be Irrigated	Date of Reclamation
11 S	2 W	15	NW $\frac{1}{4}$ of SE $\frac{1}{4}$	6.5	May 11, 1951
11 S	2 W	15	SW $\frac{1}{4}$ of SE $\frac{1}{4}$	11.8	" "
11 S	2 W	15	NW $\frac{1}{4}$ of NE $\frac{1}{4}$	8.2	" "
				29.5	

Peterson

Beginning at a point which is 11.79 chains South and 24.46 chains west of the southeast corner of Section 15 in T. 11 S., R. 2 W. of the Will. Mer. in Linn County, Oregon; and running thence North 40.04 chains to the north boundary line of the D.E.C. of Jonathan Wasson and wife, the same being No. 1186 and Claim No. 49 in said T. & R.; the west 7.33 chains; thence South 40.04 chains to a point due west of the place of beginning; thence East 7.39 chains to the place of beginning, and containing 30 acres, more or less, all lying and being in Linn County, Oregon.


15. If the ground water supply is supplemental to an existing water supply, identification of any application for a permit, permit, certificate or adjudicated right to appropriate water made or held by the registrant.

Township 11 S Range 2 W, W.M.  
North

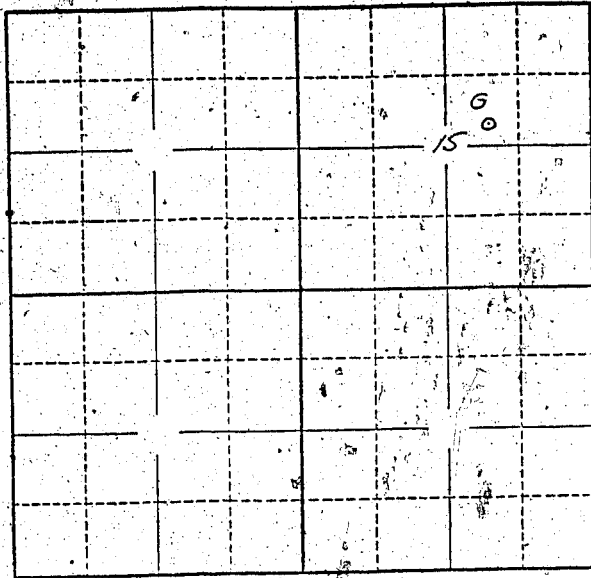

Locate well and acreage of irrigated land on plat.  
Scale: 2" = 1 Mile

STATE OF OREGON  
County of LINN

} ss.

I, J. R. and Vada Peterson being first duly sworn, do hereby certify that I have read the foregoing Registration Statement and that all of the items therein contained are true to the best of my knowledge and belief.

J. R. Peterson  
Vada H. Peterson  
(Signature of Registrant)

Subscribed and sworn to before me this 21st day of July, 1958.

My commission expires September 21, 1960.

[Signature]  
(Notary Public)

(SEAL)

**CERTIFICATE OF REGISTRATION**

STATE OF OREGON  
County of Marion

} ss.

This is to certify that the foregoing Registration Statement was received in the office of the State Engineer on the 24 day of July, 1958, at 8:00 o'clock A. M. and has been duly recorded in said office in Book No. 11 of Registration Statements on page GR 2481!

Witness my hand this 6th day of April, 1959.

[Signature]  
(State Engineer)

By \_\_\_\_\_ (Deputy)

\$1500

GR-2481