

# Registration Statement

## OF CLAIMANT OF RIGHT TO APPROPRIATE GROUND WATER

TO THE STATE ENGINEER OF OREGON:

I, Harry L. Kropf

of Rt. 3, Box 1062, Albany County of Linn

State of Oregon, do hereby make application for a certificate of registration as evidence of a right to appropriate ground water.

1. Source from which water is withdrawn is Pump Well

2. Location is: 5 miles south of Albany, Oregon

and is more particularly described as follows:

(a) 578' S. and 280' E. of NW corner of NE $\frac{1}{4}$  of S. 32, T. 11 S, R. 3 W.

being within NW $\frac{1}{4}$  of NE $\frac{1}{4}$  of Sec. 32, Twp. 11 S, Rge. 3 W

or (b) within limits of recorded platted property, town or city:

in Lot \_\_\_\_\_, Block \_\_\_\_\_ of \_\_\_\_\_

County of Linn

3. Construction Work was begun on March 1, 1950; was completed on March 7, 1952

and the ground water claimed was first used for the purposes set out below on June 1952

since which time the water has been used continuously

from June 1952 to present time

4. Quantity of water claimed and used is 60 gallons per minute; 22.5 acre feet per year

5. Purpose or Purposes for which water is used Irrigation

6. Description of Well: Depth 70 feet. Type Drilled

diameter 6 inches. Elevation of ground at well site 230 feet, mean sea level.

Depth to water table \_\_\_\_\_ feet.

7. Capacity of Well: \_\_\_\_\_ g.p.m. with \_\_\_\_\_ feet drawdown.

\_\_\_\_\_ g.p.m. with \_\_\_\_\_ feet drawdown.

Date of test Not tested

If Flowing Well: Measured discharge \_\_\_\_\_ g.p.m. on \_\_\_\_\_


Shut-in pressure at ground surface \_\_\_\_\_ lbs. per sq. in. on \_\_\_\_\_

Water is controlled by \_\_\_\_\_





Township 11 S Range 3 W, W.M.  
North

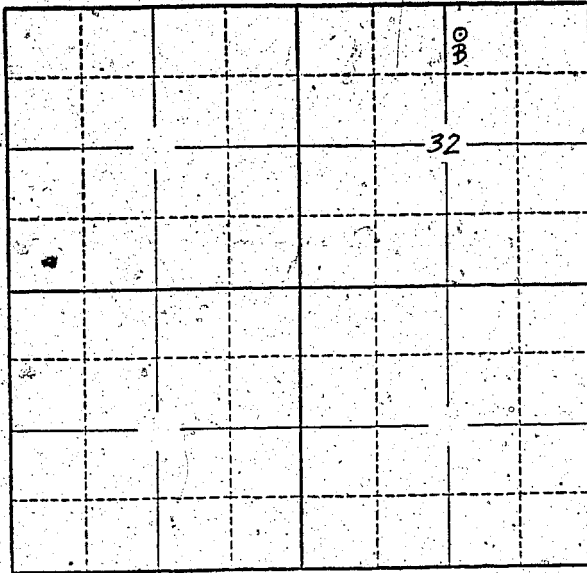

Locate well and acreage of irrigated land on plat.  
Scale: 2" = 1 Mile

STATE OF OREGON

County of LINN

} ss.

I, Harry L. Kropf, being first duly sworn, do hereby certify that I have read the foregoing Registration Statement and that all of the items therein contained are true to the best of my knowledge and belief.

Harry L. Kropf  
(Signature of Registrant)

Subscribed and sworn to before me this 23 day of July, 1958

NOTARY PUBLIC  
Commission Expires 2, 1959

My commission expires

(Notary Public)

(SEAL)

**CERTIFICATE OF REGISTRATION**

STATE OF OREGON

County of Marion

} ss.

This is to certify that the foregoing Registration Statement was received in the office of the State Engineer on the 24th day of July, 1958, at 8:00 o'clock A.M. and has been duly recorded in said office in Book No. 11 of Registration Statements on page GR-2482

Witness my hand this 6th day of April, 1959

Lewis A. Stanley  
(State Engineer)

By \_\_\_\_\_ (Deputy)

GR - 2482

\$15.00