

# Registration Statement

## OF CLAIMANT OF RIGHT TO APPROPRIATE GROUND WATER

TO THE STATE ENGINEER OF OREGON:

I, William T. & Gladys Andrews  
of Rt. 5, Box 100-A Eugene County of Lane

State of Oregon do hereby make application for a certificate of registration as evidence of a right to appropriate ground water.

1. Source from which water is withdrawn is Pump Well  
(Flowing well, pump well, infiltration trench, or tunnel)

2. Location is: 2 1/2 miles west of Eugene, Oregon City limits (on Gram Hill Drive)  
(Approximate distance and direction from nearest city or town)

and is more particularly described as follows:

(a) Eleven chains north of southwest corner of Sec. 32, T. 17 S. R. 4 W. W.M.  
(Give distance and bearing to corner of section or other legal subdivision)  
and 250 feet east to location of well.  
being within SW 1/4 of SW 1/4 of Sec. 32, Twp. 17 S., Rge. 4 W. W.M.  
(Smallest legal subdivision) (N. or S.) (E. or W.)

or (b) within limits of recorded platted property, town or city: \_\_\_\_\_

in Lot \_\_\_\_\_, Block \_\_\_\_\_ of \_\_\_\_\_  
(Name of plat or addition)  
County of Lane  
(If within city or town, give name)

3. Construction Work was begun on March 1, 1955; was completed on March 5, 1955  
(Date) (Date)

and the ground water claimed was first used for the purposes set out below on March 10, 1955  
(Date)

since which time the water has been used Continuously  
(Continuously or intermittently)

from March 10, 1955 to present date  
(Date) (Date)

4. Quantity of water claimed and used is Thirty gallons per minute; 25 acre feet per year.

5. Purpose or Purposes for which water is used Ninety-five percent irrigation; 5 percent domestic.

(Domestic, irrigation, municipal, manufacturing, industrial, etc.)

6. Description of Well: Depth 85 feet. Type Drilled  
(Dug or drilled)

diameter 6 inches. Elevation of ground at well site 665 feet, mean sea level.  
(As near as known)

Depth to water table 40 to 50 feet.

7. Capacity of Well: 30 g.p.m. with 11 1/2 feet drawdown.

\_\_\_\_\_ g.p.m. with \_\_\_\_\_ feet drawdown.

Date of test June 24, 1955

If Flowing Well: Measured discharge \_\_\_\_\_ g.p.m. on \_\_\_\_\_  
(Date)

Shut-in pressure at ground surface \_\_\_\_\_ lbs. per sq. in. on \_\_\_\_\_  
(Date)

Water is controlled by \_\_\_\_\_  
(Cap, valve, etc.)

8. Casing: (Give diameter, commercial specifications and depth below ground surface of each casing size.)

6 inch diameter Black steel pipe from 0 to 22 feet  
inch diameter from to feet  
inch diameter from to feet  
inch diameter from to feet

Describe and show depth of shoe, ~~plug~~, adapter, liner or other details:

-----  
-----

9. Perforated Casings or Screens:

none from to  
(Number per foot and size of perforations, or describe screen)  
from to  
from to  
from to

10. Log of Well: (Describe each stratum or formation clearly, indicate if water bearing, and give thickness and depth as indicated.)

MATERIAL	Thickness (Feet)	Depth to Bottom (Feet)

If log of well is not available, give name and address of driller. Mark Christensen, 3550 West 18th,

Eugene, Oregon.

11. Infiltration Trench: Covered or open none

Dimensions: Length \_\_\_\_\_ ft. Minimum depth \_\_\_\_\_ ft. Maximum depth \_\_\_\_\_ ft.

Bottom width \_\_\_\_\_ ft. Discharge \_\_\_\_\_ g.p.m. Date of test \_\_\_\_\_

12. Tunnel: Type of lining none

Dimensions: \_\_\_\_\_  
(Length, course, and cross sectional size)

Position of water bearing stratum with reference to portal of tunnel \_\_\_\_\_

Log of tunnel: (Preceding table for log of well may be used, if desired. Give footage from portal and character of materials, as pertinent.)

13. Pumping Equipment:

(a) Pump Berkeley Submersible 4 inch. Capacity 30 g.p.m.  
(Make, type and size)


(b) Motor 1 horsepower  
(Type and horsepower)

14. Location of area irrigated or to be irrigated, or place of use if for purposes other than irrigation.

Township North or South	Range E. or W. of Williamsite Meridian	Section	Forty-acre Tract	Number Acres To Be Irrigated	Date of Reclamation
17 S	4 W	32	SW $\frac{1}{4}$ of SW $\frac{1}{4}$	14	March 10, 1955

15. If the ground water supply is supplemental to an existing water supply, identification of any application for a permit, permit, certificate or adjudicated right to appropriate water made or held by the registrant.

Township 17 S Range 4 W W.M.  
North

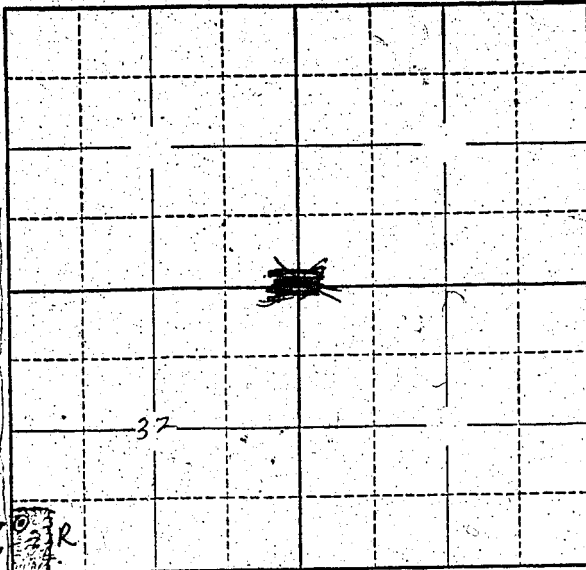

Existing well →  
Irrigated Land →

Locate well and acreage of irrigated land on plat.  
Scale: 2" = 1 Mile

STATE OF OREGON }  
County of Lane } ss.

I, William T. & Gladys Andrews, being first duly sworn, do hereby certify that I have read the foregoing Registration Statement and that all of the items therein contained are true to the best of my knowledge and belief.

*William T. Andrews*  
*Gladys V. Andrews*  
(Signature of Registrant)

Subscribed and sworn to before me this 3rd day of July, 1958

My commission expires \_\_\_\_\_  
Elden T. [Signature]  
(Notary Public)

(SEAL)

CERTIFICATE OF REGISTRATION

STATE OF OREGON }  
County of Marion } ss.

This is to certify that the foregoing Registration Statement was received in the office of the State Engineer on the 24th day of July, 1958, at 2:00 o'clock A.M. and has been duly recorded in said office in Book No. 11 of Registration Statements on page GR-2485

Witness my hand this 6th day of April, 1959

*Henry A. Stanley*  
(State Engineer)

4/500

By \_\_\_\_\_ (Deputy)

GR - 2485