

# Registration Statement

## OF CLAIMANT OF RIGHT TO APPROPRIATE GROUND WATER

TO THE STATE ENGINEER OF OREGON:

I, NEIL LOUIS EMMONS

of 5440 HAYESVILLE DRIVE County of MARION

State of OREGON, do hereby make application for a certificate of registration as evidence of a right to appropriate ground water.

1. Source from which water is withdrawn is Pump well  
(Flowing well, pump well, infiltration trench, or tunnel)

2. Location is: 4 miles north Salem  
(Approximate distance and direction from nearest city or town)

and is more particularly described as follows: about 2300 ft. North of 1900 ft. west from SE corner Section 5,

(a) SOUTH 9° WEST 2244.0 FEET AND NORTH 89°49' WEST 691.18 FT. FROM THE NORTHEAST CORNER OF THE JOHN MARTIN DONATION LAND CLAIM  
(Give distance and bearing to corner of section or other legal subdivision)  
being within SW 1/4 of SE 1/4 of Sec. 5, Twp. 7 SOUTH, Rge. 7 WEST  
(Smallest legal subdivision) (N. or S.) (E. or W.)

or (b) within limits of recorded platted property, town or city:

in Lot \_\_\_\_\_, Block \_\_\_\_\_ of \_\_\_\_\_  
(Name of plat or addition)

County of \_\_\_\_\_  
(If within city or town, give name)

3. Construction Work was begun on JUNE 1954; was completed on JULY 1954  
(Date) (Date)

and the ground water claimed was first used for the purposes set out below on JULY 1954  
(Date)

since which time the water has been used CONTINUOUSLY  
(Continuously or intermittently)

from JULY 1954 to JULY 1958  
(Date) (Date)

4. Quantity of water claimed and used is 60 gallons per minute; \_\_\_\_\_ acre feet per year.

5. Purpose or Purposes for which water is used HOUSE HOLD USE & IRRIGATION

(Domestic, irrigation, municipal, manufacturing, industrial, etc.)

6. Description of Well: Depth 100 feet. Type DRILLED  
(Dug or drilled)

diameter 6 inches. Elevation of ground at well site 200 feet, mean sea level.  
(As near as known)

Depth to water table 20 feet.

7. Capacity of Well: 100 g.p.m. with 20 feet drawdown.

\_\_\_\_\_ g.p.m. with \_\_\_\_\_ feet drawdown.

Date of test JULY 1954

If Flowing Well: Measured discharge \_\_\_\_\_ g.p.m. on \_\_\_\_\_  
(Date)


Shut-in pressure at ground surface \_\_\_\_\_ lbs. per sq. in. on \_\_\_\_\_  
(Date)

Water is controlled by \_\_\_\_\_  
(Cap, valve, etc.)





Township 75 Range 2W W.M. North

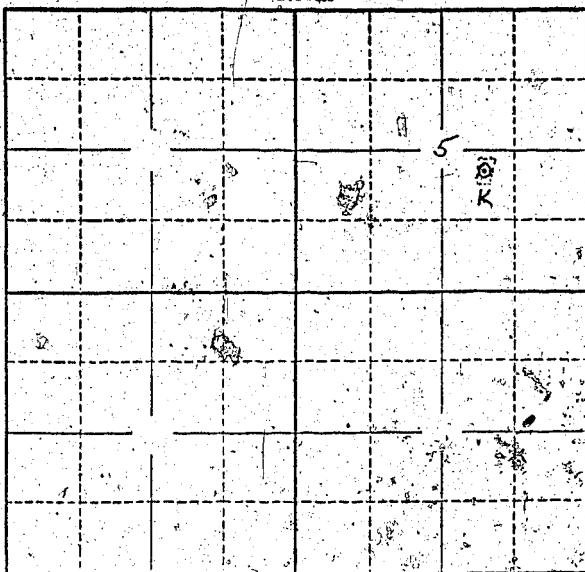

Locate well and acreage of irrigated land on plat.  
Scale: 2" = 1 Mile

STATE OF OREGON

County of Marion } ss.

I, \_\_\_\_\_, being first duly sworn, do hereby certify that I have read the foregoing Registration Statement and that all of the items therein contained are true to the best of my knowledge and belief.

Neil Emmons  
(Signature of Registrant)

Subscribed and sworn to before me this 30th day of July, 1958.

My commission expires 12th June 1961

Wm. S. Bartholomew  
(Notary Public)

(SEAL)

**CERTIFICATE OF REGISTRATION**

STATE OF OREGON

County of Marion } ss.

This is to certify that the foregoing Registration Statement was received in the office of the State Engineer on the 30th day of July, 1958, at 2:00 o'clock P. M. and has been duly recorded in said office in Book No. 11 of Registration Statements on page GR-2487

Witness my hand this 6th day of April, 1959.

Lucre A. Stanley  
(State Engineer)

By \_\_\_\_\_ (Deputy)

#1500

GR - 2487