

Registration Statement

OF CLAIMANT OF RIGHT TO APPROPRIATE GROUND WATER

(Under Chapter 708, Oregon Laws 1955.)

TO THE STATE ENGINEER OF OREGON:

I, Victor M. Burch
of Clowerdale County of Tillamook
State of Oregon, do hereby make application for a certificate of registration as evidence of a right to appropriate ground water.

1. Source from which water is withdrawn is a Pump Well
(Flowing well, pump well, infiltration trench, or tunnel)

2. Location is: 1/2 mile SW of Clowerdale Oregon
(Approximate distance and direction from nearest city or town)

and is more particularly described as follows: 1042' N and 735' W from SE corner of
(a) SE 1/4 of NW 1/4 of Section 27 T45 R10W
(Give distance and bearing to corner of section or other legal subdivision)

being within SE 1/4 of NW 1/4 of Sec. 27, Twp. 9S, Rge. 10W
(Smallest legal subdivision) (N. or S.) (E. or W.)

or (b) within limits of recorded platted property, town or city: _____

in Lot _____, Block _____ of _____
(Name of plat or addition)

County of Tillamook
(If within city or town, give name)

3. Construction Work was begun on Sept. 1951; was completed on about 4 day later
(Date) (Date)

and the ground water claimed was first used for the purposes set out below on a few day later, 1951
(Date)

since which time the water has been used intermittently
(Continuously or intermittently)

from May or June to Oct.
(Date) (Date)

4. Quantity of water claimed and used is 90 gallons per minute; 24 acre feet per year.

5. Purpose or Purposes for which water is used SPRINKLER irrigation

(Domestic, irrigation, municipal, manufacturing, industrial, etc.)

6. Description of Well: Depth 82 feet. Type drilled
(Dug or drilled)

diameter 8 inches. Elevation of ground at well site 10 feet, mean sea level.
(As near as known)

Depth to water table 6 to 8 feet.

7. Capacity of Well: 90 g.p.m. with 14 feet drawdown. of ground level

test pumps 130 g.p.m. with 20 feet drawdown.

Date of test Sept. 1951

If Flowing Well: Measured discharge _____ g.p.m. on _____
(Date)

Shut-in pressure at ground surface _____ lbs. per sq. in. on _____
(Date)

Water is controlled by _____
(Cap, valve, etc.)

8. Casing: (Give diameter, commercial specifications and depth below ground surface of each casing size.)

8 inch diameter from top to 82 feet
 inch diameter from to feet
 inch diameter from to feet
 inch diameter from to feet

Describe and show depth of shoe, plug, adapter, liner or other details:

9. Perforated Casings or Screens:

Perforated from 25 to 35 ft
 (Number per foot and size of perforations, or describe screen)
 and gain from 65 to 82 ft
 from to
 from to

10. Log of Well: (Describe each stratum or formation clearly, indicate if water bearing, and give thickness and depth as indicated.)

MATERIAL	Thickness (Feet)	Depth to Bottom (Feet)
Bottom loam	4"	
Blue Shale	21"	
Sand & Gravel	10"	
Blue Shale	30"	
Sand, Gravel, and Boulder	16"	
Solid rock	1"	

If log of well is not available, give name and address of driller. Paul Ross Aloha Oregon

11. Infiltration Trench: Covered or open
 Dimensions: Length ft. Minimum depth ft. Maximum depth ft.
 Bottom width ft. Discharge g.p.m. Date of test

12. Tunnel: Type of lining
 Dimensions:
(Length, course, and cross sectional size)
 Position of water bearing stratum with reference to portal of tunnel

Log of tunnel: (Preceding table for log of well may be used, if desired. Give footage from portal and character of materials, as pertinent.)


13. Pumping Equipment:
 (a) Pump Pacific Centrifical 1 1/2 Capacity 90 g.p.m.
(Make, type and size)
 (b) Motor Electric 5 H.P.
(Type and horsepower)

14. Location of area irrigated or to be irrigated, or place of use if for purposes other than irrigation.

Township North or South	Range E. or W. of Willamette Meridian	Section	Forty-acre Tract	Number Acres To Be Irrigated	Date of Reclamation
T4S	R10W	27	NW 1/4 of NW 1/4	1.0	1951
T4S	R10W	27	NE 1/4 + NW 1/4	5.9	"
T4S	R10W	27	SW 1/4 of NW 1/4	4.5	"
T4S	R10W	27	SE 1/4 of NW 1/4	16.3	"
				<u>25.7</u>	"

15. If the ground water supply is supplemental to an existing water supply, identification of any application for a permit, permit, certificate or adjudicated right to appropriate water made or held by the registrant.

Township 45 Range 10W, W.M.
North

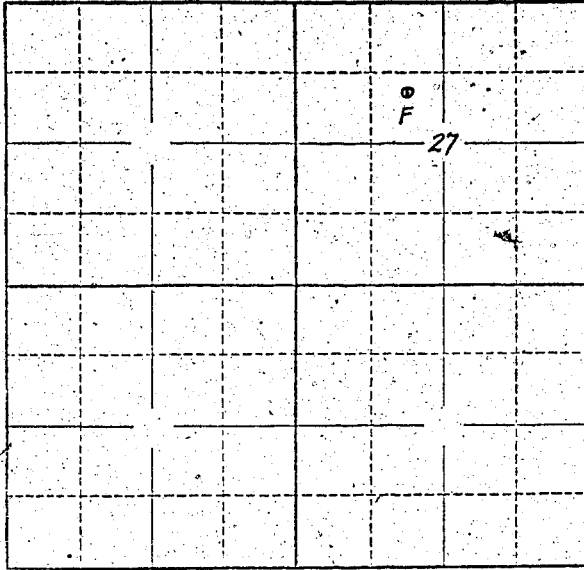

Locate well and acreage of irrigated land on plat.
Scale: 2" = 1 Mile

STATE OF OREGON }
County of Tillamook } ss.

I, Victor Werth, being first duly sworn, do hereby certify that I have read the foregoing Registration Statement and that all of the items therein contained are true to the best of my knowledge and belief.

Victor Werth
(Signature of Registrant)

Subscribed and sworn to before me this 17th day of July, 1958.

My commission expires 7-13-61

Jack Ruff
(Notary Public)

(SEAL)

CERTIFICATE OF REGISTRATION

STATE OF OREGON }
County of Marion } ss.

This is to certify that the foregoing Registration Statement was received in the office of the State Engineer on the 24th day of July, 1958, at 8⁰⁰ o'clock A.M. and has been duly recorded in said office in Book No. 11 of Registration Statements on page GR-2488

~~Construction shall be completed by _____ and the water completely applied to beneficial use by _____~~

Witness my hand this 6th day of April, 1959.

Lewis A. Stanley
(State Engineer)

\$15.00

By _____ (Deputy)

GR-2488