

Registration Statement

OF CLAIMANT OF RIGHT TO APPROPRIATE GROUND WATER

TO THE STATE ENGINEER OF OREGON:

Well No. 3 (Wanner Place)

I, Oscar H. Loe

of Route 1, Box 144, Silverton, Oregon, County of Marion

State of Oregon, do hereby make application for a certificate of registration as evidence of a right to appropriate ground water.

1. Source from which water is withdrawn is Pump Well #3 (Flowing well, pump well, infiltration trench, or tunnel)

2. Location is: 1 mile east and 3 miles north of Silverton, Oregon (Approximate distance and direction from nearest city or town)

and is more particularly described as follows:

(a) N. 7 degrees 21 minutes W 2355 ft. from SE cor. Sec. 13 T6S R1W WM being within NE 1/4 SE 1/4 of Sec. 13, Twp. 6S, Rge. 1W (Give distance and bearing to corner of section or other legal subdivision) (Smallest legal subdivision) (N. or S.) (E. or W.)

or (b) within limits of recorded property, town or city:

in Lot, Block of (Name of plat or addition)

County of (If within city or town, give name)

3. Construction Work was begun on Aug. 1951; was completed on Aug. 1951 (Date) (Date)

and the ground water claimed was first used for the purposes set out below on June 1952 (Date)

since which time the water has been used Intermittently (Continuously or intermittently)

from June 1952 to July 1952 (Date) (Date)

4. Quantity of water claimed and used is 150 gallons per minute; acre feet per year.

5. Purpose or Purposes for which water is used Domestic, irrigation, and livestock (Domestic, irrigation, municipal, manufacturing, industrial, etc.)

6. Description of Well: Depth 192 feet. Type Drilled (Dug or drilled)

diameter 12 inches. Elevation of ground at well site Not known feet, mean sea level. (As near as known)

Depth to water table 21 feet.

7. Capacity of Well: 150 g.p.m. with 30 feet drawdown. g.p.m. with feet drawdown.


Date of test Sept 1951

If Flowing Well: Measured discharge g.p.m. on (Date)

Shut-in pressure at ground surface lbs. per sq. in. on (Date)

Water is controlled by (Cap, valve, etc.)

Township 6S Range 1E, W.M.
North

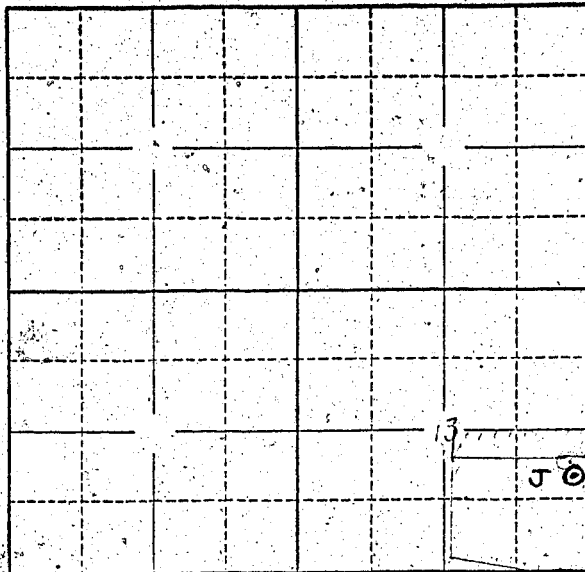

Locate well and acreage of irrigated land on plat.
Scale: 2" = 1 Mile

STATE OF OREGON

County of Marion } ss.

I, Oscar H. Lae, being first duly sworn, do hereby certify that I have read the foregoing Registration Statement and that all of the items therein contained are true to the best of my knowledge and belief.

Oscar H. Lae
(Signature of Registrant)

Subscribed and sworn to before me this 24 day of July, 1958

My commission expires 12th June 1961 Wm. S. Brinkman
(Notary Public)

(SEAL)

CERTIFICATE OF REGISTRATION

STATE OF OREGON } ss.
County of Marion

This is to certify that the foregoing Registration Statement was received in the office of the State Engineer on the 24th day of July, 1958, at 9:00 o'clock A. M. and has been duly recorded in said office in Book No. 11 of Registration Statements on page GR 2493

Witness my hand this 6th day of April, 1959

Stuart A. Stanley
(State Engineer)

By _____ (Deputy)

GR-2493

#26-35